

#### **Letter of Response**

To whom it may concern,

The following corrections were made to the plans titled "The Aria":

- 1.A demo permit will be applied for by the builder or his representative.
- 2. Window labeled "G" has been labeled as tempered glass to comply with R308.4.5.
- 3. Window schedule has been updated to notate egress to meet requirements of R310.2.
- 4. Stamped Truss package will be uploaded by the builder or applicant.
- 5. Sheet S5 has been updated to show a vapor barrier at slab per R506.2.3.

Sanjay Sanverma

# THE ARIA

**APPLICABLE CODES:** 

AMENDMENTS (2020); INTERNATIONAL RESIDENTIAL CODE, 2018 EDITION, WITH GEORGIA AMENDMENTS; INTERNATIONAL FIRE CODE, 2018 EDITION, (NO GEORGIA AMENDMENTS); INTERNATIONAL PLUMBING CODE, 2018 EDITION, WITH GEORGIA AMENDMENTS; INTERNATIONAL MECHANICAL CODE, 2018 EDITION, WITH GEORGIA AMENDMENTS; INTERNATIONAL FUEL GAS CODE, 2018 EDITION, WITH GEORGIA AMENDMENTS; INTERNATIONAL ELECTRICAL CODE, 2018 EDITION, WITH GEORGIA AMENDMENTS; INTERNATIONAL ENERGY CONSERVATION CODE, 2018 EDITION, WITH GEORGIA SUPPLEMENTS AND AMENDMENTS; INTERNATIONAL SWIMMING POOL AND SPA CODE, 2018 EDITION, WITH GEORGIA AMENDMENTS.

# SCOPE OF WORK: NEW 4 BEDROOM, $3\frac{1}{2}$ BATH SINGLE FAMILY HOME

# DRAWING LIST:

- **COVER PAGE**
- FLOOR PLAN
- **ROOF PLAN**
- FRONT AND REAR ELEVATION
- RIGHT AND LEFT ELEVATION
- **INTERIOR ELEVATIONS**
- **ELECTRICAL PLAN**
- PLUMBING PLAN
- **HVAC PLAN**
- **ROOF FRAMING PLAN**
- WALL FRAMING PLAN
- **CEILING JOIST PLAN**
- FOUNDATION PLAN
- FOUNDATION DETAIL INTERIOR BEARING FOOTING C-TYPICAL COLUMN DETAIL WALL SECTION
- SECTION A-A AND SECTION B-B
- TYPICAL FRAMING DETAILS-1
- TYPICAL FRAMING DETAILS-2
- TYPICAL FRAMING DETAILS-3

# **GENERAL NOTES:**

THIS PLAN WAS DESIGNED AND CRAFTED BY "SANVERMA DESIGN", TO MEET AVERAGE CONDITIONS AND CODES IN THE STATE AND AT THE TIME IT WAS DESIGNED. THIS PLAN WAS ALSO DESIGNED FOR SEISMIC SITE CLASS D. BECAUSE CODES AND REQUIREMENTS CAN CHANGE AND MAY VARY FROM JURISDICTION TO JURISDICTION, CANNOT WARRANT COMPLIANCE WITH ANY SPECIFIC CODE OR REGULATION. CONSULT YOUR LOCAL BUILDING OFFICIAL TO DETERMINE THE SUITABILITY OF THESE PLANS FOR YOUR SPECIFIC SITE AND APPLICATION. THIS PLAN CAN BE ADAPTED TO YOUR LOCAL BUILDING CODES AND REQUIREMENTS, HOWEVER, IT IS THE RESPONSIBILITY OF THE PURCHASER AND/OR BUILDER OF THIS PLAN TO SEE THAT THE STRUCTURE IS BUILT IN STRICT COMPLIANCE WITH ALL GOVERNING MUNICIPAL CODES (CITY, COUNTY, STATE AND FEDERAL). THE PURCHASER AND/OR BUILDER OF THIS PLAN RELEASES THE DESIGNER FROM ANY CLAIMS OR LAWSUITS THAT MAY ARISE DURING THE CONSTRUCTION OF THIS STRUCTURE OR ANYTIME THEREAFTER.

- IF THE CONTRACTOR OR SUB-CONTRACTOR, IN THE COURSE OF THEIR WORK FINDS ANY DISCREPANCIES BETWEEN THE PLAN AND THE PHYSICAL CONDITIONS OF THE SITE OR STRUCTURE, OR ANY ERRORS IN THE PLANS OR SPECIFICATIONS, IT SHALL BE THEIR RESPONSIBILITY TO IMMEDIATELY INFORM ADI, WHO WILL PROMPTLY VERIFY AND IF NECESSARY CORRECT THE WORKING DRAWINGS. ANY WORK DONE ĂFTER SUCH DISCOVERY WILL BE DONE AT THE CONTRACTOR'S EXPENSE.
- **DESIGN LOADS:**

FLOOR: 40 PSF. LIVE, 15 PSF. DEAD ROOF: 30 PSF. LIVE, 10 PSF. DEAD CEILING: 10 PSF. LIVE, 5 PSF. DEAD

**UNLESS NOTED OTHERWISE** 

 SOIL BEARING CAPACITY - 1500 PSF. LOADS, SEISMIC ZONING AND ACCORDINGLY, SEE YOUR LOCAL BUILDING OFFICIALS FOR VERIFICATION OF YOUR SPECIFIC LOAD DATA, ZONING RESTRICTIONS AND SITE CONDITIONS, CONCRETE AND FOUNDATIONS: \* ALL FOUNDATION WALLS AND SLABS ON GRADE SHALL BE 3000 PSI (28-DAY COMPRESSIVE STRENGTH CONCRETE)

## **CONCRETE AND FOUNDATIONS:**

- ALL FOUNDATION WALLS AND SLABS ON GRADE SHALL BE 3000 PSI (28-DAY COMPRESSIVE STRENGTH CONCRETE). UNLESS NOTED
- ALL INTERIOR SLABS ON GRADE SHALL BEAR ON 4" COMPACTED GRANULAR FILL WITH 6 MIL. POLYFTHYLFNF VAPOR BARRIFR
- PROVIDE PROPER EXPANSION AND CONTROL JOINTS AS PER LOCAL ALL 36" X 36" X 18" CONCRETE PADS TO HAVE (3) #5 RODS EACH
- ALL 48" X 48" X 24" CONCRETE PADS TO HAVE (4) #5 RODS EACH
- VERIFY DEPTH OF FROST FOOTINGS WITH YOUR LOCAL CODES.

PROVIDE TERMITE PROTECTION AS REQUIRED BY HUD MINIMUM

- PROPERTY STANDARDS.
- FOUNDATION BOLTS MUST BE ANCHORED TO SILL PLATE WITH 5/8" BOLTS EMBEDDED 15" IN CONCRETE WALLS.

- ALL STRUCTURAL STEEL FOR BEAMS AND PLATES SHALL COMPLY WITH ASTM SPECIFICATION A-36
- ALL STRUCTURAL STEEL FOR STEEL COLUMNS SHALL COMPLY WITH ASTM SPECIFICATION A-53 GRADE B OR A-501. ALL REINFORCING STEEL FOR CONCRETE SHALL COMPLY WITH
- ASTM SPECIFICATION A-615 GRADE 60. # PROVIDE STEEL SHIMNS IN ALL BEAM POCKETS.
- STEEL COLUMNS ARE TO BE 3" I.D. (INSIDE DIAMETER) UNLESS NOTED OTHERWISE.

### FRAMING MEMBERS:

- UNLESS NOTED OTHERWISE, ALL FRAMING LUMBER SHALL HAVE THE FOLLOWING CHARACTERISTICS:
- FB: 1,000 PSI FV = 75 PSI E = 1,400,000 PSI

- CONTRACTOR TO CONFIRM THE SIZE, SPACING AND STRESS CHARACTERISTICS OF ALL FRAMING AND STRUCTURAL MEMBERS TO MEET YOUR LOCAL CODE REQUIREMENTS
- HOLE SIZES AND LOCATIONS IN GLULAM OR LAMINATED VENEERED LUMBER (L.V.L.) MEMBERS ARE TO BE CONFIRMED BY A
- ANY STRUCTURAL OR FRAMING MEMBERS NOT INDICATED ON THE PLAN ARE TO BE SIZED BY CONTRACTOR DOUBLE FLOOR JOISTS UNDER ALL PARTITION WALLS, UNLESS
- NOTED OTHERWISE. ALL SUB FLOORING IS ASSUMED TO BE 3/4" THICK, GLUED &
- ALL EXTERIOR WALLS ARE DIMENSIONED TO OUTSIDE OF 1/2"
- SHEATHING. CALCULATED DIMENSIONS TAKE PRECEDENCE OVER SCALED
- ALL ANGLED WALLS ON FLOOR PLANS ARE AT 45 DEGREE ANGLE, UNLESS OTHERWISE NOTED.
- LATERALLY UNSUPPORTED WALLS 12'-0" HIGH OR HIGHER SHALL BE 2X6 AND BALLOON FRAMED UNLESS OTHERWISE NOTED.
- UNLESS NOTED OTHERWISE, ABOVE ALL OPENINGS THAT ARE: 1. LOAD BEARING AND LESS THAN OR EQUAL TO 3 FT.
- 2. LOAD BEARING AND MORE THAN 3 FT. - USE (2) 2X12 WITH 1/2" PLYWOOD BETWEEN.
- 3. NON-LOAD BEARING AND LESS THAN OR EQUAL TO 6 FT. - USE 4X6.
- 4. NON-LOAD BEARING AND MORE THAN 6 FT.
- USE (2) 2X12 WITH 1/2" PLYWOOD BETWEEN
- 5. ALL EXTERIOR OPENINGS
- USE (2) 2X12 WITH 1/2" PLYWOOD BETWEEN ALL TRUSSES TO BE ENGINEERED BY TRUSS MANUFACTURER
- ACCORDING TO THE LOADING INDICATED ON THIS PLAN. ALL EXTERIOR CORNERS SHALL BE BRACED IN EACH DIRECTION
- WITH LET-IN DIAGONAL BRACING OR PLYWOOD.
- PLACE (1) ROW OF 1" X 3" CROSS-BRIDGING ON ALL SPANS OVER 8-0" AND (2) ROWS OF 1" X 3" CROSS-BRIDGING ON ALL SPANS
- COLLAR TIES ARE TO BE SPACED 4'-0" 0.C.

- ALL PURLINS AND KICKERS ARE TO BE 2X6'S, UNLESS NOTED OTHERWISE.
- ANY HIP OR VALLEY RAFTERS OVER A 28'-0" SPAN ARE TO BE LAMINATED VENEER LUMBER L.V.L.)


#### MISC. NOTES:

- PREFABRICATED FIREPLACES AND FLUES ARE TO BE UIL APPROVED AND INSTALLED AS PER MANUFACTURER'S SPECIFICATIONS.
- ALL MATERIALS, SUPPLIES AND EQUIPMENT TO BE INSTALLED AS PER MANUFACTURER'S SPECIFICATIONS AND PER LOCAL CODES AND REQUIREMENTS.
- PROVIDE PROPER INSULATION FOR ALL PLUMBING.
- 1/2" WATER-RESISTANT DRYWALL AROUND SHOWERS, TUBS AND
- 1/2" DRYWALL ON INTERIOR WALLS AND CEILINGS. • 5/8" TUPE "X" FIRE CODE DRYWALL ON GARAGE WALLS AND
- WHEN NO BRAND IS SPECIFIED WINDOWS ARE CALLED OUT BY **GLASS SIZE ONLY**
- WINDOWS, IF NOT NOTED, ARE ASSUMED TO BE CASEMENTS
- HEADER HEIGHTS ARE LABELED TO BOTTOM OF ARCHED TRANSOMS, CONFIRM WINDOW OPENINGS FOR YOUR LOCAL EGRESS REQUIREMENTS AND MINIMUM LIGHT AND VENTILATION
- PROVIDE PROPER HANDRAILS AT STAIRS PER LOCAL CODES
- THE MECHANICAL AND ELECTRICAL LAYOUTS ARE SUGGESTED ONLY. CONSULT YOUR MECHANICAL AND ELECTRICAL CONTRACTORS FOR EXACT SPECIFICATIONS, LOCATIONS AND SIZES. JOG FLUE TO REAR OF RIDGE AS NECESSARY.
- PROVIDE PROPER WIRING FOR ALL ELECTRICAL APPLIANCES, MECHANICAL EOUIPMENT AND WHIRLPOOLS PER 'MANUFACTURER'S SPECIFICATIONS.
- AIR CONDITIONER LOCATIONS MAY VARY DEPENDING ON RESTRICTIVE COVENANTS AND CODES.



2836 SF LIVING AREA: 936 SF **GARAGE:** FRONT PORCH: 78 SF 384 SF **REAR PORCH:** 192 SF PATIO:

4426 SF **TOTAL FLOOR AREA:** 

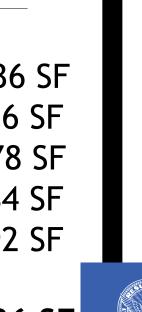



BB-202409525 / 2594 CASCADE RD SW

# THIS PLAN IS APPROVED FOR CONSTRUCTION

The approval of plans shall not prevent the Building Official from thereafter requiring the correction of errors in the plans and specifications, or from preventing building operations being carried on thereunder when in violation of the building code, zoning ordinance, or any other ordinance in the City of Atlanta.

> (470)716-3479 ANTWAN HODGES 12-24-24


> > **NEW SFR**

APPLICATION NUMBER


KEEP THIS APPROVED PLAN ON JOB SITE DURING CONSTRUCTION

RELEASED FOR CONSTRUCTION



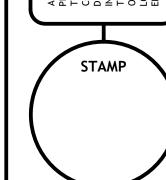



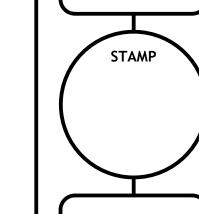

## GENERAL NOTES:

- 1. IT IS THE CONTRACTOR'S RESPONSIBILITY TO FIELD VERIFY THE EXACT LOCATION OF ALL UTILITY SERVICES AND SLOPE PRIOR TO RID/INSTALLATION
- SERVICES AND SLOPE PRIOR TO BID/INSTALLATION.

  2. CONTRACTOR SHALL FIELD VERIFY ALL EXISTING CONDITIONS BEFORE COMMENCING WORK AND REPORT ANY AND ALL DISCREPANCIES BETWEEN ACTUAL CONDITIONS AND THESE PLANS TO THE
- ENGINEER/ARCHITECT IMMEDIATELY.

  3. CONTRACTOR SHALL MAKE ALL NECESSARY MODIFICATIONS DURING THE CONSTRUCTION PROCESS TO COMPLY WITH I.R.C. (INTERNATIONAL RESIDENTIAL CODE), LATEST EDITION, OR APPLICABLE
- CODES AT SITE.

  4 CONTRACTOR SHALL VERIEV ALL INTERIOR FINISHES FLOOR COVERINGS AND TRIM SIZES &
- CONFIGURATIONS WITH OWNER PRIOR TO CONSTRUCTION.

  5. IT IS THE SOLE RESPONSIBILITY OF THE CONTRACTOR TO VERIFY CLEARANCES OF THE ITEMS
- MENTIONED IN THE DRAWINGS PRIOR TO THE CONSTRUCTION.
- 6. EXTERIOR WALL AND ROOF FINISHES AS PER CUSTOMER'S CHOICE.7. REFER TO MANUFACTURER'S SPECS FOR ROUGH OPENING DIMENSIONS, FOR DOOR AND WINDOWS.
- 8. ALL BEAMS SIZES TO BE VERIFIED BY THE STRUCTURAL ENGINEER.

		DC	OR SCHI	EDULE
	WIDTH	HEIGHT	QTY.	DESCRIPTION
1	6'-0"	8'-0"	1	FRONT DOOR
2	18'-0"	8'-0"	1	DOUBLE GARAGE DOOR
3	9'-0"	8'-0"	1	SINGLE GARAGE DOOR
4	3'-0"	8'-0"	1	SOLID DOOR
5	16'-0"	8'-0"	1	4 PANEL SLIDING GLASS DOOR
6	3'-0"	6'-8"	2	FIRE RATED DOOR
7	2'-8"	6'-8"	8	HOLLOW CORE
8	2'-4"	6'-8"	7	HOLLOW CORE
9	6'-0"	6'-8"	2	SLIDING CLOSET DOOR
10	5'-0"	6'-8"	2	SLIDING CLOSET DOOR
11)	2'-4"	6'-8"	3	POCKET DOOR

WINDOW SCHEDULE								
	WIDTH	HEIGHT	QTY.	DESCRIPTION				
(A)	5'-0"	6'-0"	4	CASEMENT (DOUBLE) (EGRESS)				
B	7'-6"	6'-0"	2	CASEMENT (TRIPLE) (EGRESS)				
<u>C</u>	3'-0"	1'-6"	1	FIXED (TEMPERED GLASS)				
<b>D</b>	2'-6"	6'-0"	2	CASEMENT (EGRESS)				
E	7'-6"	4'-0"	1	CASEMENT (TRIPLE) (EGRESS)				
F	5'-0"	1'-6"	1	TRANSOM (TEMPERED GLASS)				
G	4'-0"	4'-0"	1	FIXED (TEMPERED GLASS)				

AREA CALCULATION							
LIVING AREA:	2836 SF						
GARAGE:	936 SF						
FRONT PORCH:	78 SF						
REAR PORCH:	384 SF						
PATIO:	192 SF						
TOTAL FLOOR AREA:	4426 SF						


### NOTE: 10'-0" FLAT CEILING OTHERWISE NOTED


NOTE: BUILDING HEIGHT: 21' 11 5/8"

NOTE:

 ALL BATHROOM WINDOWS ARE TEMPERED GLASS TO COMPLY WITH SECTION R308.4.5
 ALL BEDROOM WINDOWS ARE EGRESS WINDOWS TO COMPLY WITH SECTION



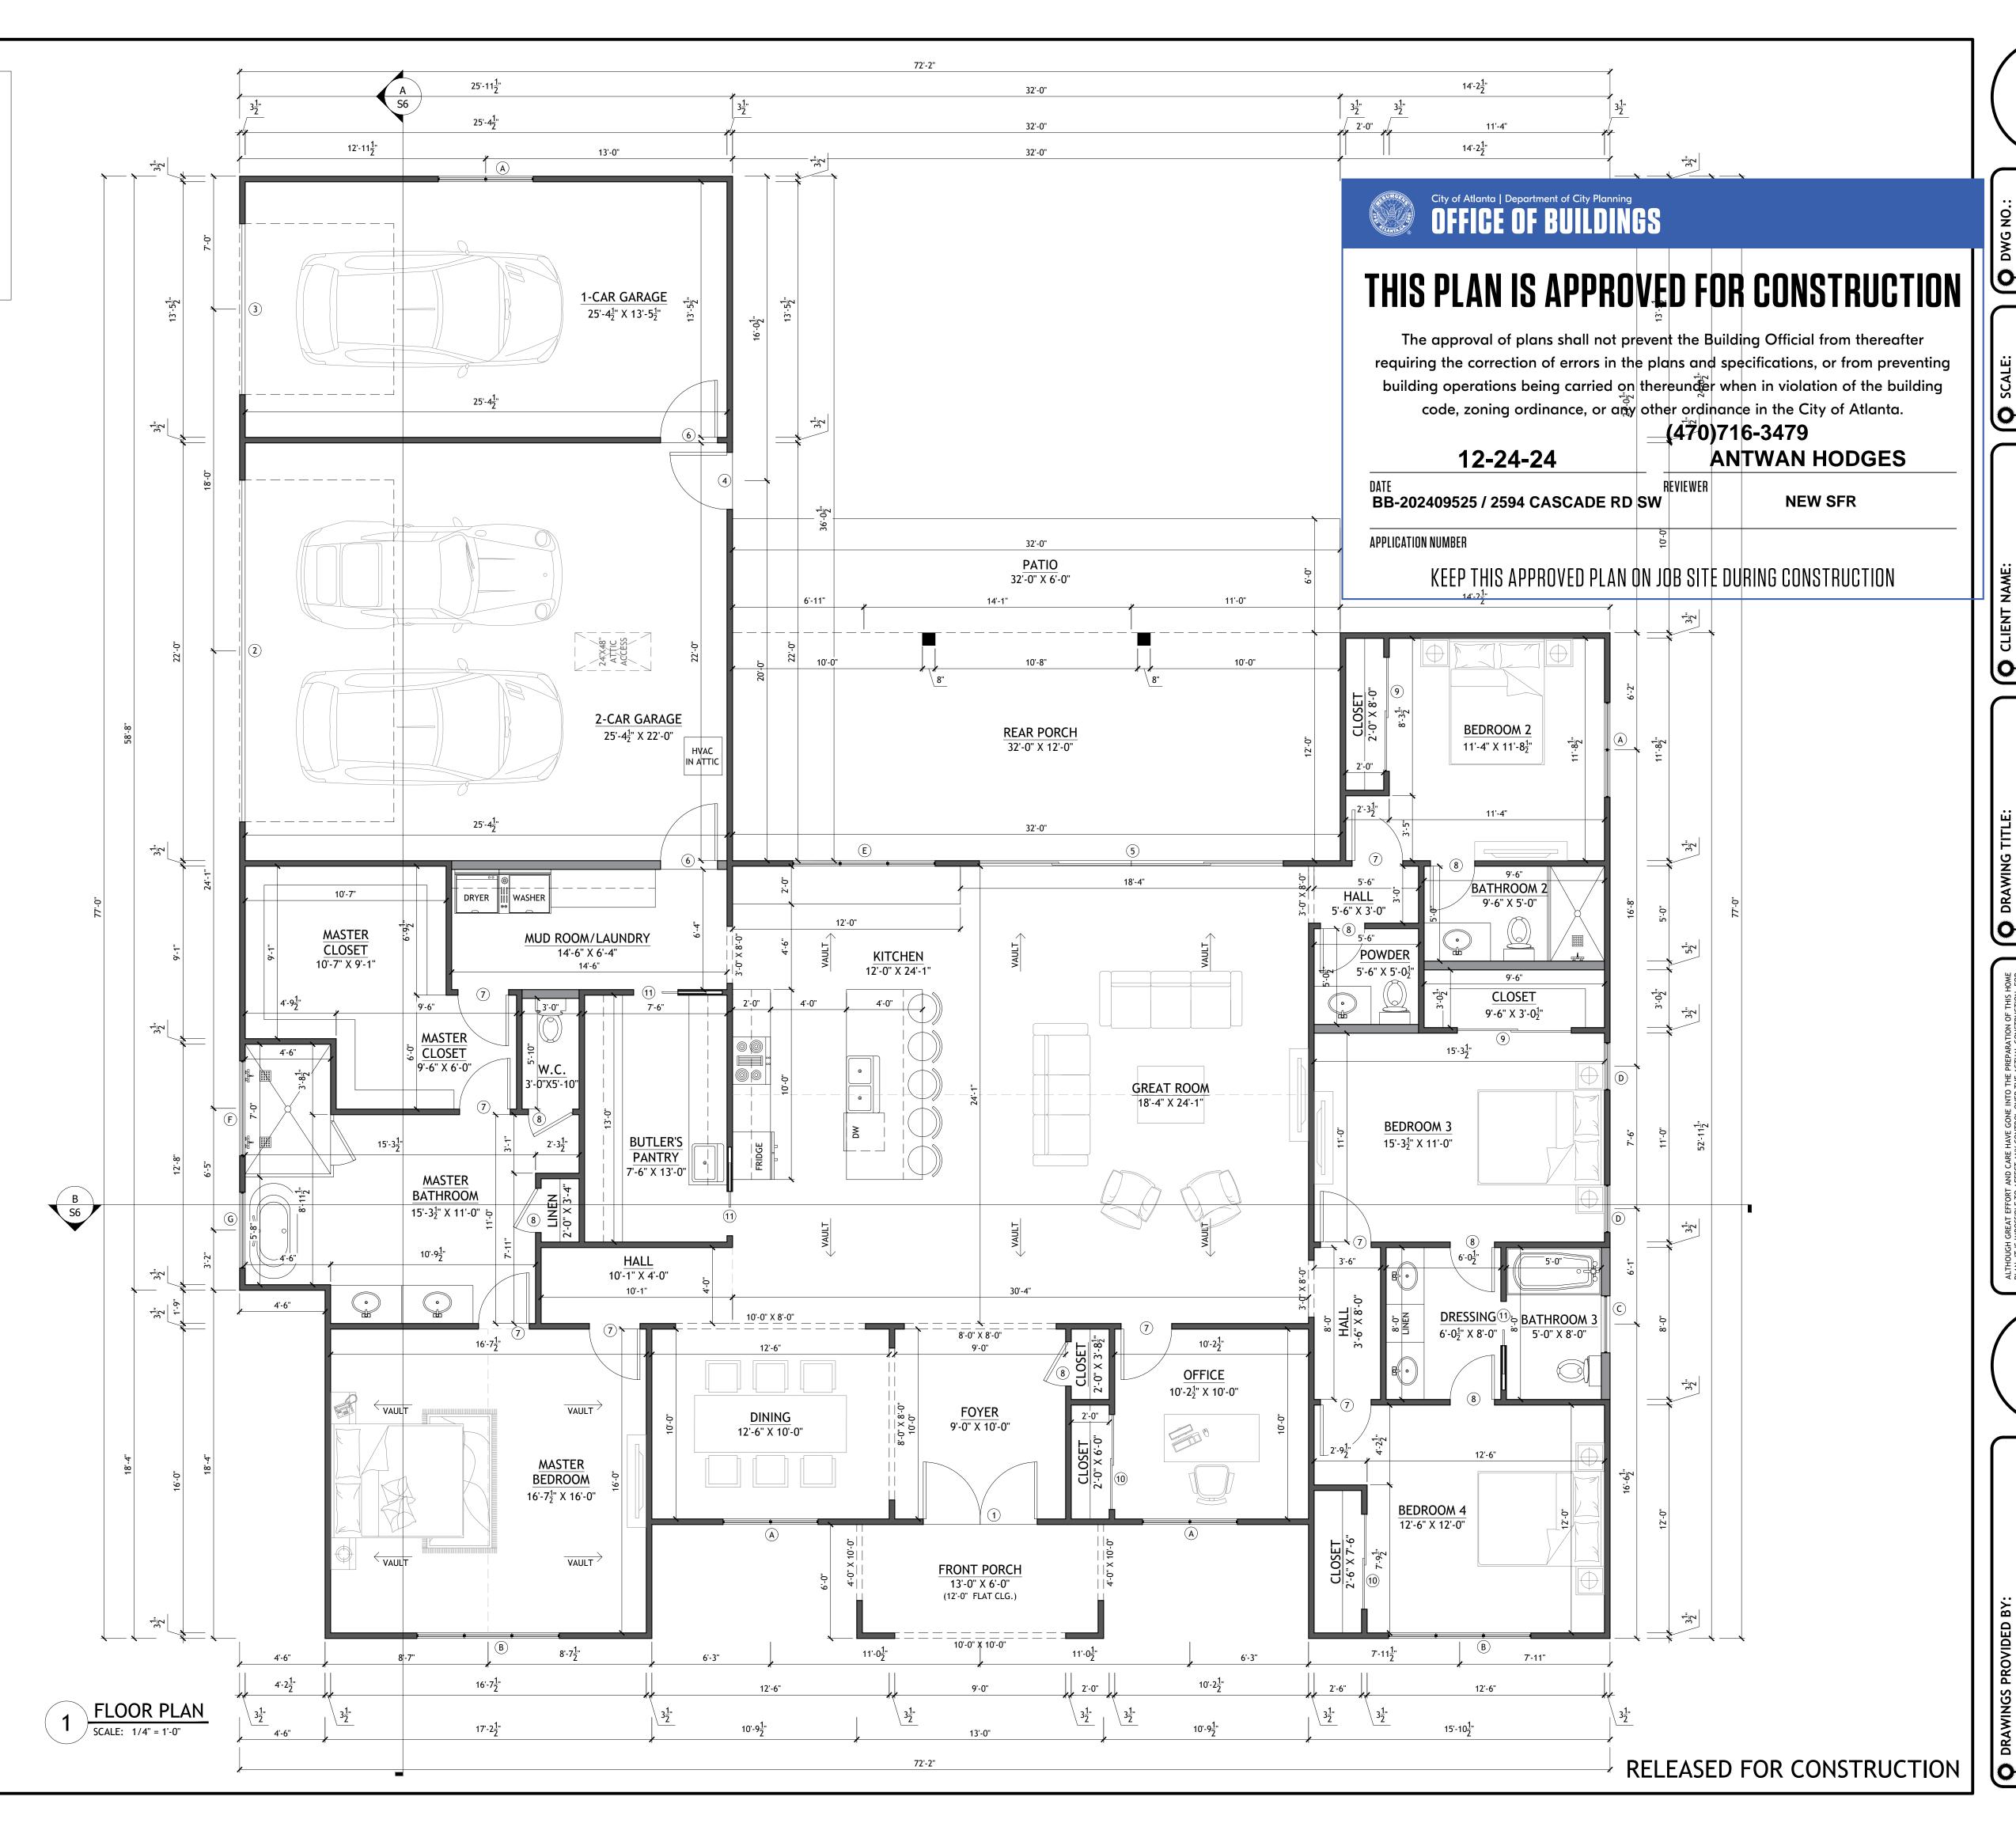

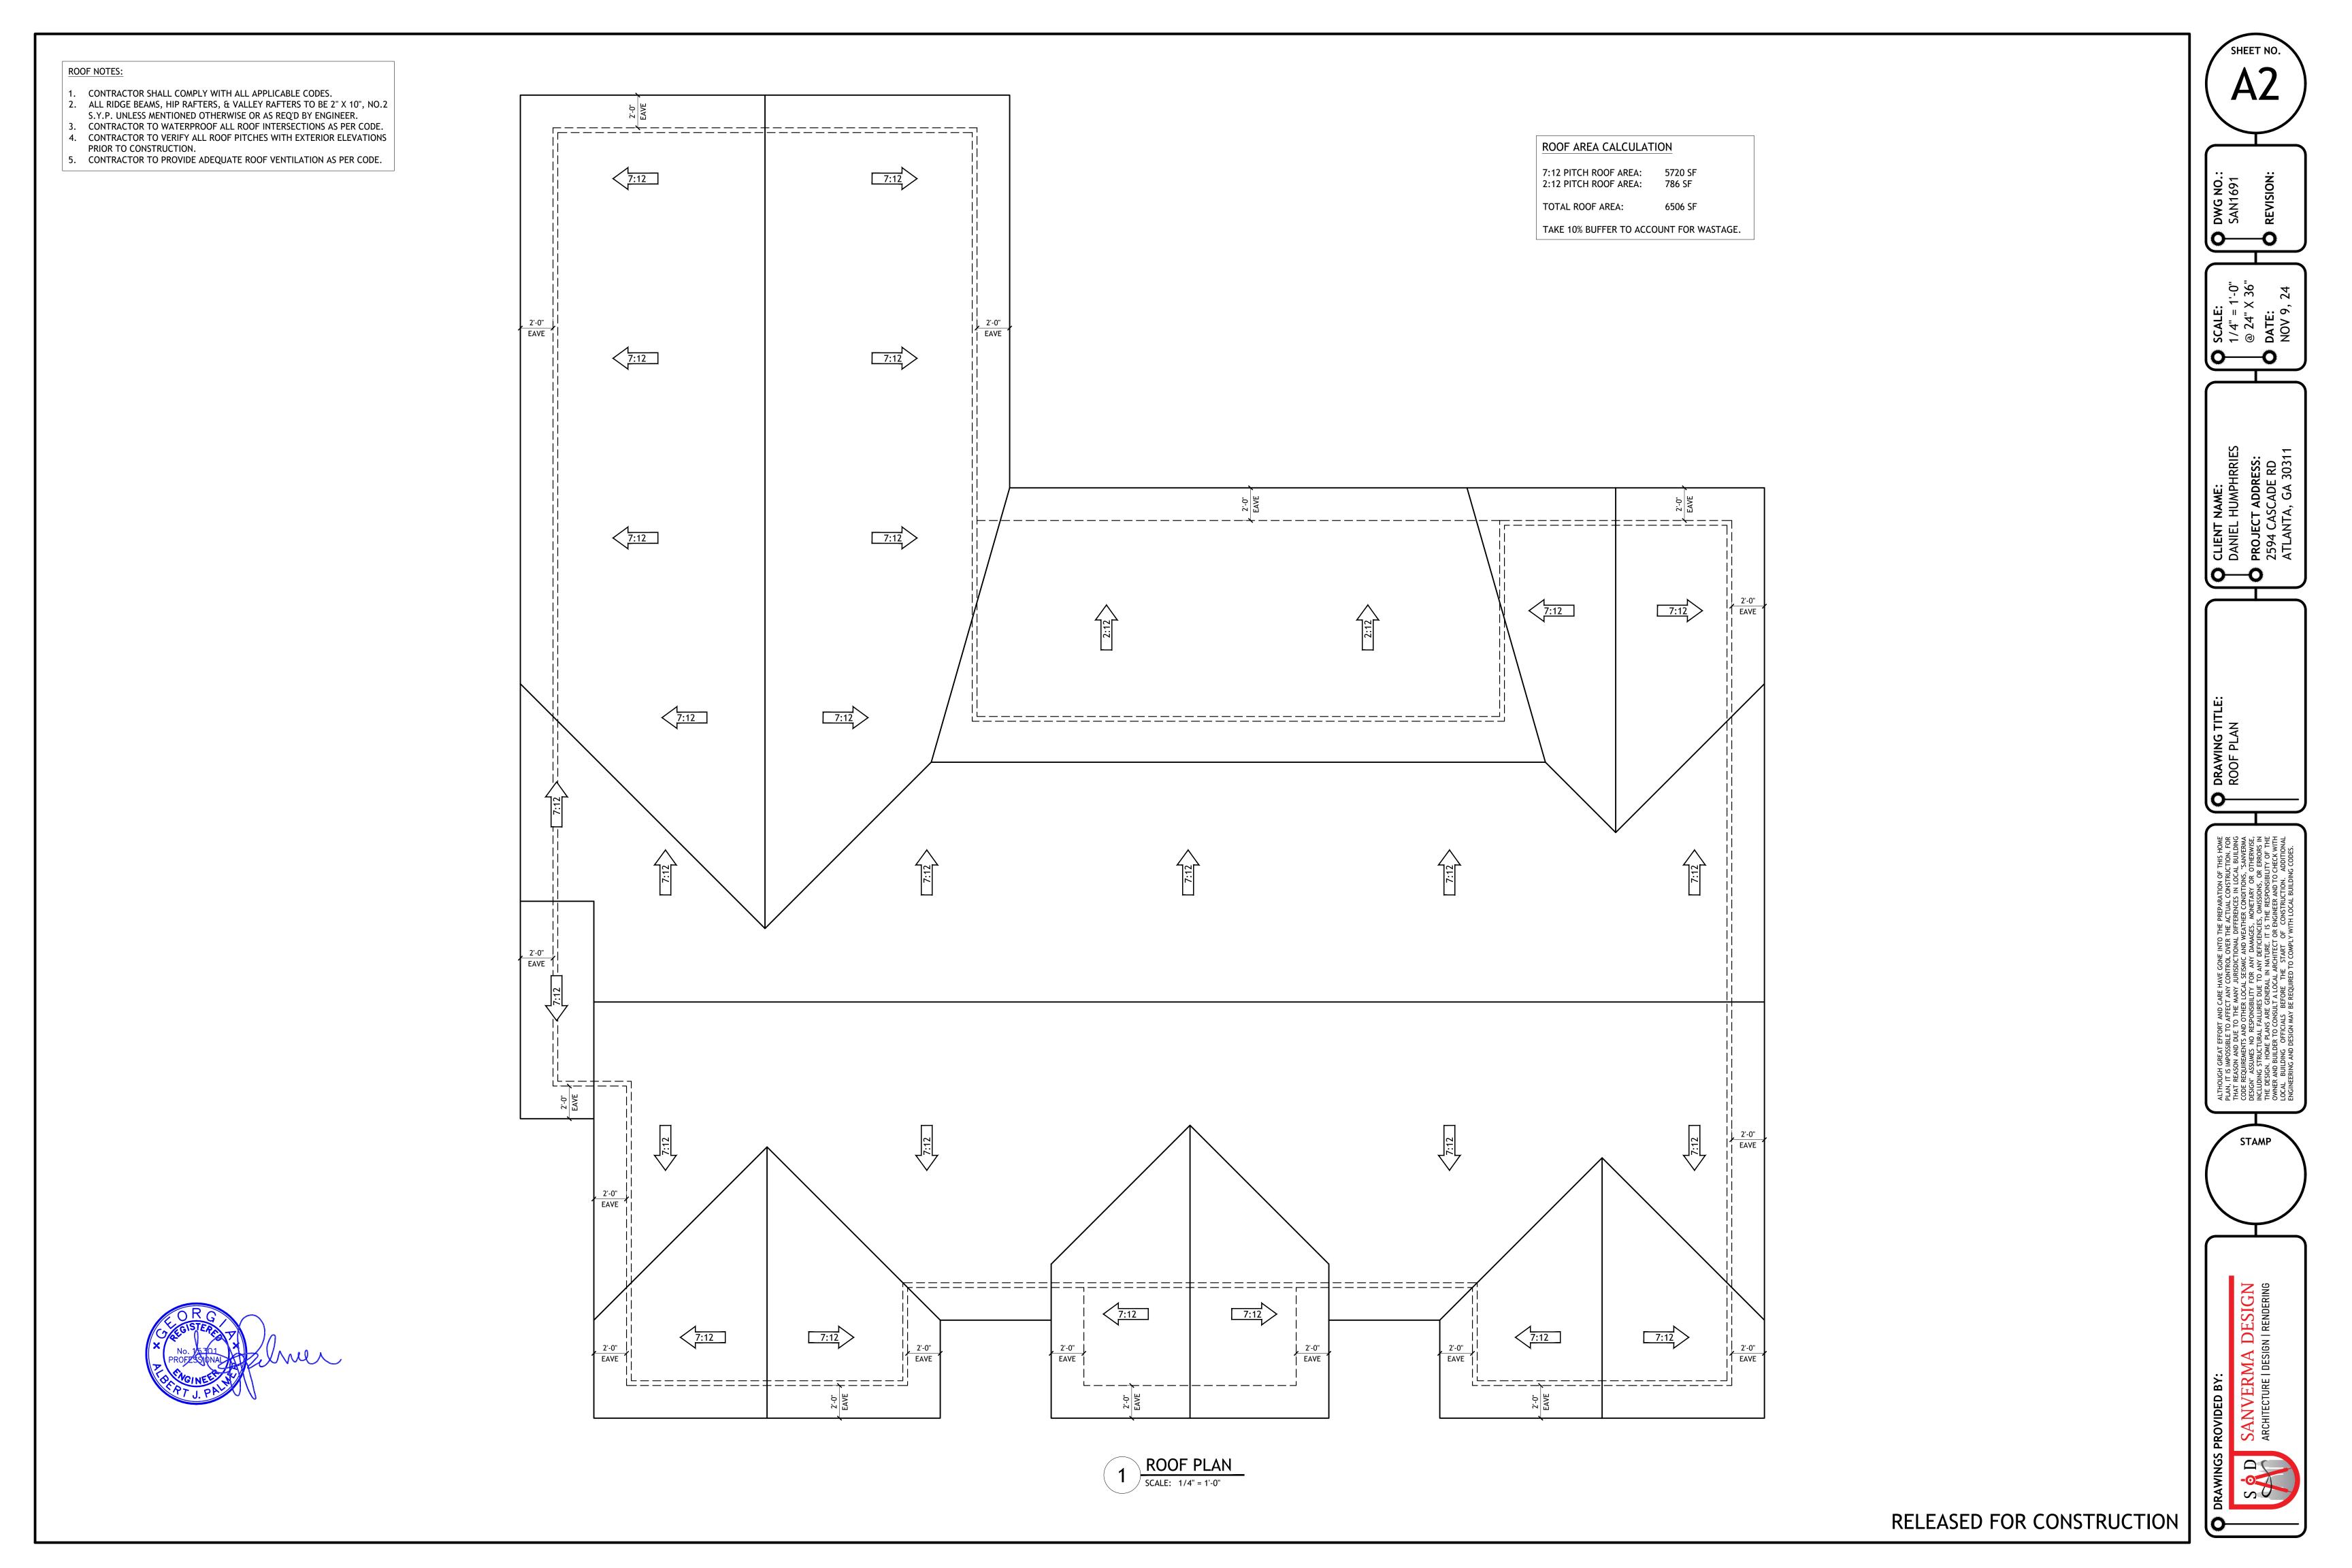

#### EXTERIOR ELEVATION NOTES:


- 1. CONTRACTOR TO VERIFY ALL WINDOW AND DOOR STYLES AND SIZES WITH OWNER PRIOR TO CONSTRUCTION.
- 2. PROVIDE STEPS AND GUARD RAILS AS PER CODE BASED ON SITE CONDITIONS.
- 3. GROUND LINES SHOWN FOR REFERENCE ONLY AND VARY DEPENDING ON SITE CONDITIONS.
- 4. ALL FINISH MATERIALS TO BE VERIFIED WITH OWNER PRIOR TO CONSTRUCTION.
- 5. REFER TO TYPICAL WALL DETAIL FOR FRAMING METHODS
- AND OTHER MISC. INFORMATION.

  6. CONTRACTOR TO PROVIDE ADEQUATE ROOF VENTILATION AS REQ'D BY CURRENT CODES.



FRONT ELEVATION

SCALE: 1/4" = 1'-0"

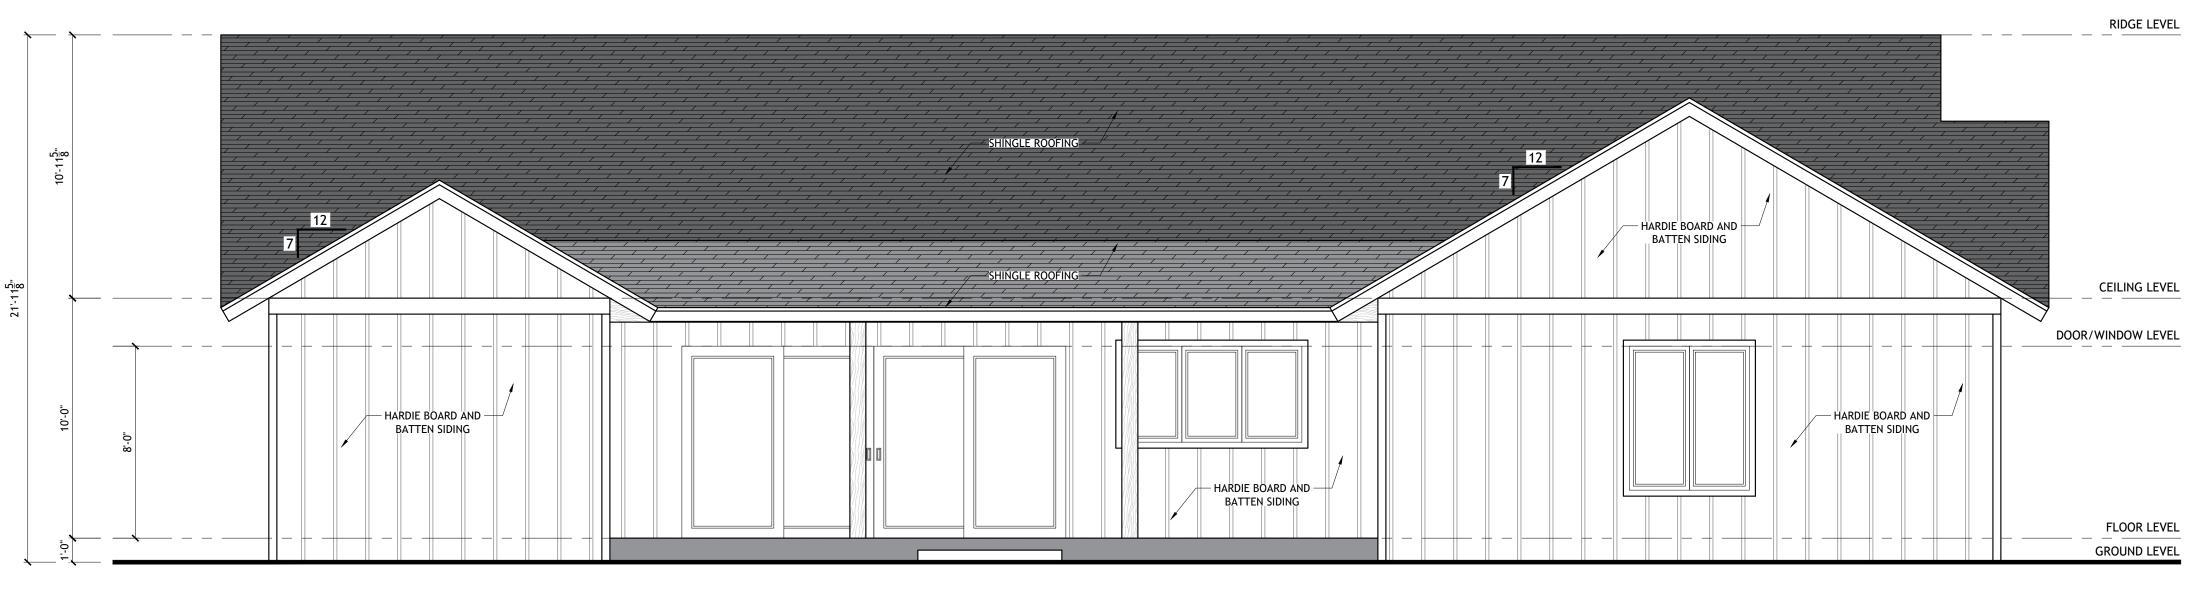

2 REAR ELEVATION

SCALE: 1/4" = 1'-0"



#### GENERAL NOTES:


- 1. IT IS THE CONTRACTOR'S RESPONSIBILITY TO FIELD VERIFY THE EXACT LOCATION OF ALL UTILITY
  SERVICES AND SLOPE PRIOR TO RID/INSTALL ATION
- SERVICES AND SLOPE PRIOR TO BID/INSTALLATION.


  2. CONTRACTOR SHALL FIELD VERIFY ALL EXISTING CONDITIONS BEFORE COMMENCING WORK AND
- REPORT ANY AND ALL DISCREPANCIES BETWEEN ACTUAL CONDITIONS AND THESE PLANS TO THE ENGINEER/ARCHITECT IMMEDIATELY.

  3. CONTRACTOR SHALL MAKE ALL NECESSARY MODIFICATIONS DURING THE CONSTRUCTION PROCESS.
- 3. CONTRACTOR SHALL MAKE ALL NECESSARY MODIFICATIONS DURING THE CONSTRUCTION PROCESS TO COMPLY WITH I.R.C. (INTERNATIONAL RESIDENTIAL CODE), LATEST EDITION, OR APPLICABLE
- CODES AT SITE.

  4. CONTRACTOR SHALL VERIFY ALL INTERIOR FINISHES, FLOOR COVERINGS, AND TRIM SIZES &
- CONFIGURATIONS WITH OWNER PRIOR TO CONSTRUCTION.

  5. IT IS THE SOLE RESPONSIBILITY OF THE CONTRACTOR TO VERIFY CLEARANCES OF THE ITEMS
- MENTIONED IN THE DRAWINGS PRIOR TO THE CONSTRUCTION.
- 6. EXTERIOR WALL AND ROOF FINISHES AS PER CUSTOMER'S CHOICE.7. REFER TO MANUFACTURER'S SPECS FOR ROUGH OPENING DIMENSIONS, FOR DOOR AND WINDOWS.
- 8. ALL BEAMS SIZES TO BE VERIFIED BY THE STRUCTURAL ENGINEER.

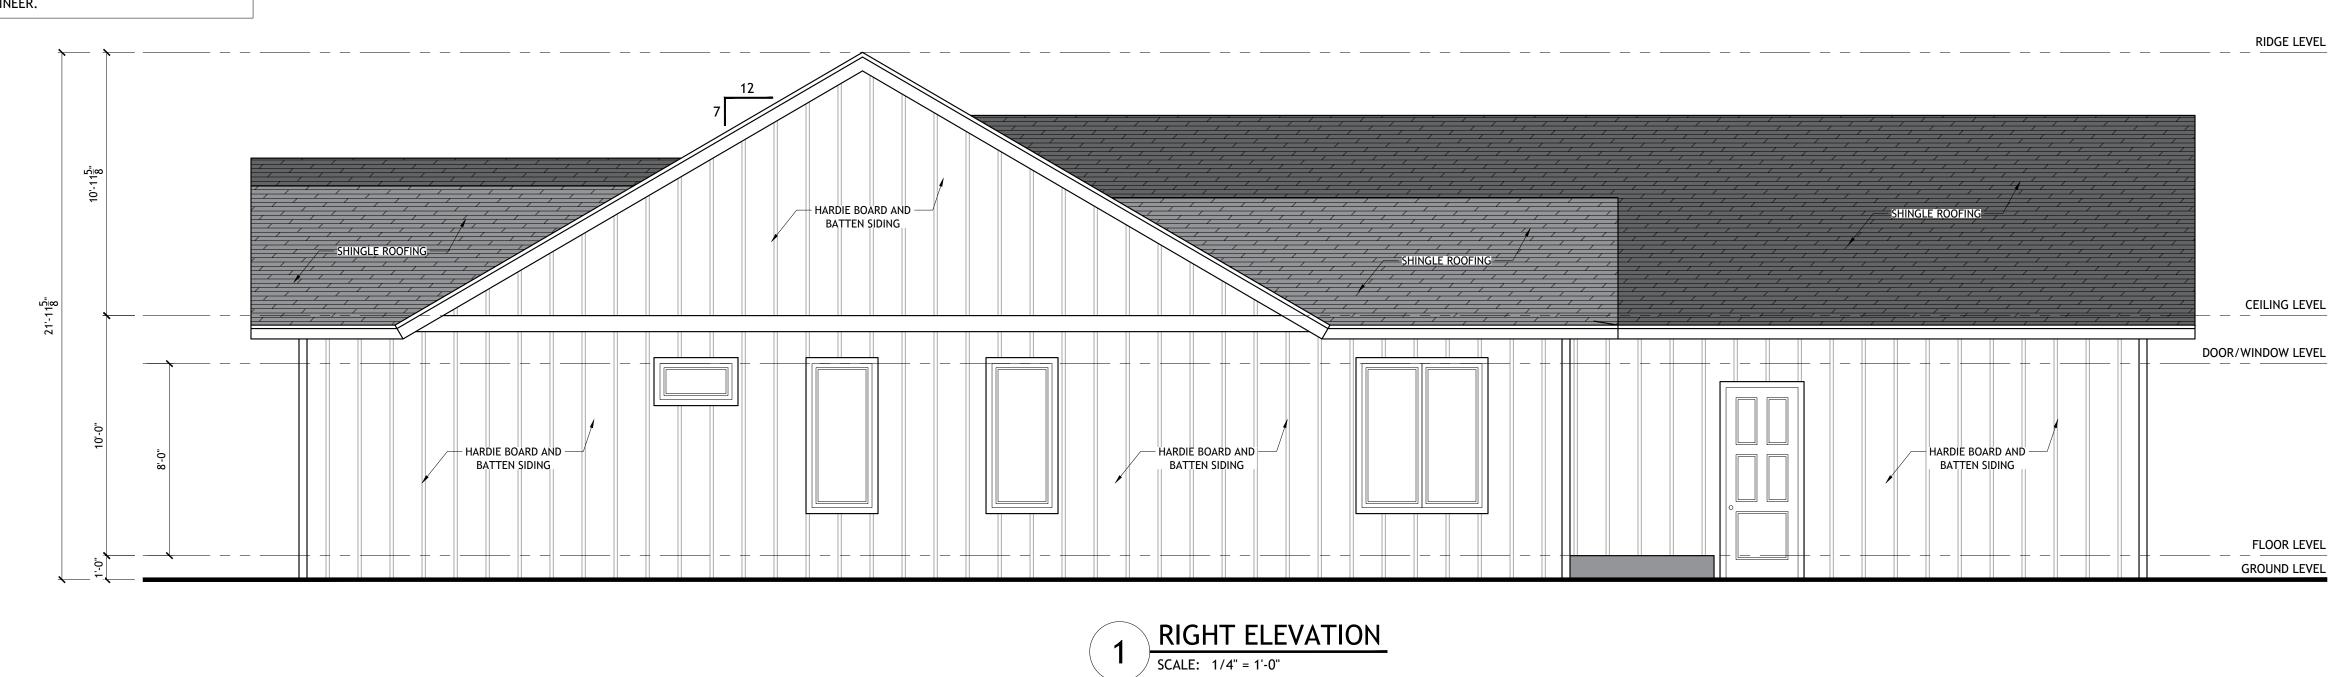

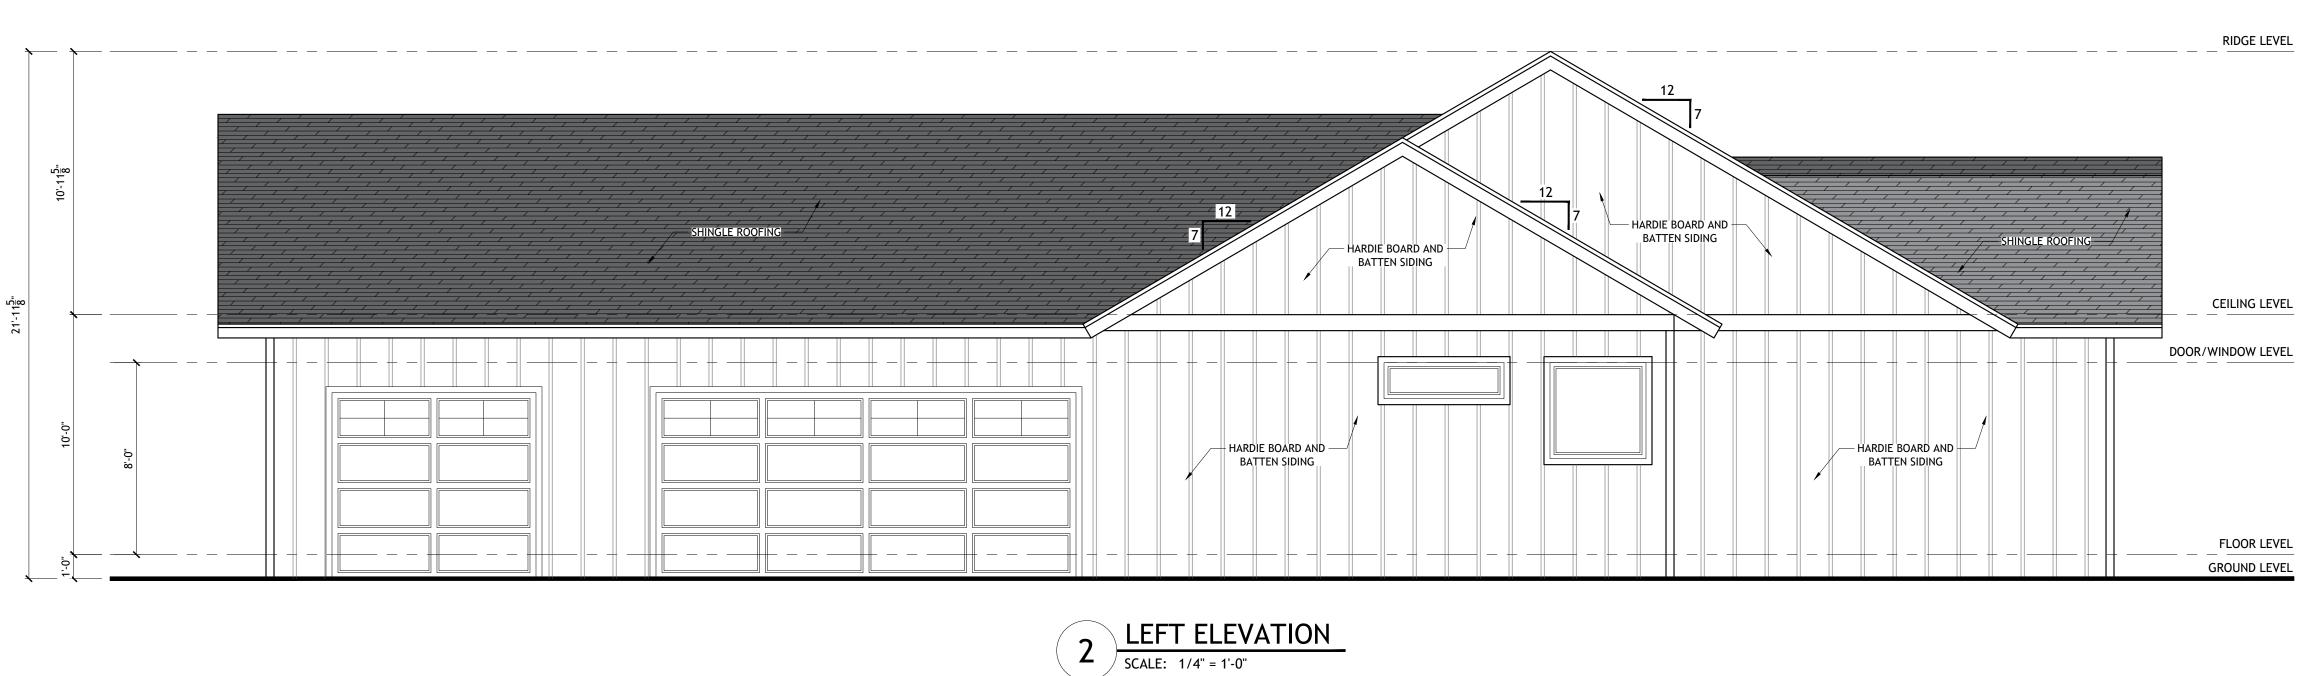





#### ELECTRICAL NOTES:

- 1. IT IS THE CONTRACTOR'S RESPONSIBILITY TO FIELD VERIFY THE EXACT LOCATION OF ALL UTILITY SERVICES AND SLOPE PRIOR TO BID/INSTALLATION.
- 2. CONTRACTOR SHALL FIELD VERIFY ALL EXISTING CONDITIONS BEFORE COMMENCING WORK AND REPORT ANY AND ALL DISCREPANCIES BETWEEN ACTUAL CONDITIONS AND THESE PLANS TO THE ENGINEER (ARCHITECT IMMEDIATELY)
- TO THE ENGINEER/ARCHITECT IMMEDIATELY.

  3. CONTRACTOR SHALL MAKE ALL NECESSARY MODIFICATIONS DURING THE CONSTRUCTION PROCESS TO COMPLY WITH I.R.C. (INTERNATIONAL RESIDENTIAL CODE), LATEST EDITION,
- OR APPLICABLE CODES AT SITE.


  4. CONTRACTOR SHALL COORDINATE WITH OTHER TRADES TO ENSURE INSTALLATION IS MADE IN ACCORDANCE WITH THE CONTRACT DOCUMENTS.
- 5. EXACT LOCATIONS AND MOUNTING HEIGHTS OF ALL LIGHTING FIXTURES, WALL OUTLETS, ETC. SHALL BE IN ACCORDANCE WITH THE LOCAL CODE AND THE CONTRACTOR ON SITE SHALL MAKE MODIFICATIONS AS NEEDED.
- 6. ALL LIGHTING CHOICES TO BE OWNER'S CHOICE, BUT TO NOT SURPASS DESIGN STANDARDS.
- ALL WORK SHALL COMPLY WITH ALL CODES APPLICABLE AT SITE.
   SMOKE ALARMS SHALL BE INSTALLED IN THE FOLLOWING LOCATIONS: EACH SLEEPING ROOM, OUTSIDE EACH SEPARATE SLEEPING AREA IN THE IMMEDIATE VICINITY OF THE BEDROOMS, ON EACH ADDITIONAL STORY OF THE DWELLING, INCLUDING BASEMENTS AND HABITABLE ATTICS. WHEN MORE THAN ONE SMOKE ALARM IS REQUIRED TO BE INSTALLED WITHIN A DWELLING THE ALARM DEVICES SHALL BE INTERCONNECTED IS SUCH A MANNER THAT THE


ACTUATION OF ONE ALARM WILL ACTIVATE ALL OF THE ALARMS IN THE UNIT. SMOKE


- ALARMS SHALL BE HARD WIRED WITH A BATTERY BACK UP.

  9. CARBON MONOXIDE ALARMS SHALL BE INSTALLED OUTSIDE OF EACH SEPARATE SLEEPING AREA IN THE IMMEDIATE VICINITY OF THE BEDROOMS IN DWELLING UNITS WITHIN WHICH FUEL-FIRED APPLIANCES ARE INSTALLED AND IN DWELLING UNITS WITH ATTACHED GARAGES.
- 10. A 125 VOLT, SINGLE PHASE, 15-20 AMPERE RATED RECEPTACLE OUTLET SHALL BE INSTALLED AT AN ACCESSIBLE LOCATION FOR THE SERVICING OF HEATING, AIR CONDITIONING AND REFRIGERATION EQUIPMENT. THE RECEPTACLE SHALL BE LOCATED ON THE SAME LEVEL AND WITHIN 25 FEET OF THE EQUIPMENT. THE RECEPTACLE OUTLET SHALL NOT BE CONNECTED TO THE LOAD SIDE OF THE HVAC EQUIPMENT DISCONNECTING MEANS.

ELECTRICAL LEGEND	
120 VOLT RECEPTACLE	<b>=</b>
120 VOLT W/ GROUND FAULT INTERRUPTOR	<del>⊜</del> <sub>GFI</sub>
240 VOLT RECEPTACLE	<del>=</del>
WATERPROOF RECEPTACLE	<del>€w</del> P
PHONE/CABLE (CAT5)	◀
TELEVISION ANTENNA	#
SINGLE POLE SWITCH	\$
2 WAY SWITCH	<b>\$</b> <sub>2</sub>
CEILING MOUNTED HANGING LIGHT	Ø
RECESSED CAN LIGHT	0
FLUSH MOUNTED LIGHT	0
WALL MOUNTED LIGHT	Ω
EXHAUST FAN	•
EXHAUST FAN/ RECESS CAN COMBO	
SMOKE DETECTOR	⊠sd
CARBON MONOXIDE DETECTOR	<b>∆</b> CD
STAIRCASE LIGHT	
GARAGE LIGHT	
UNDER CABINET LIGHT	
CCTV CAMERA	[CAM]
CEILING FAN WITH LIGHT	
NOTE:	

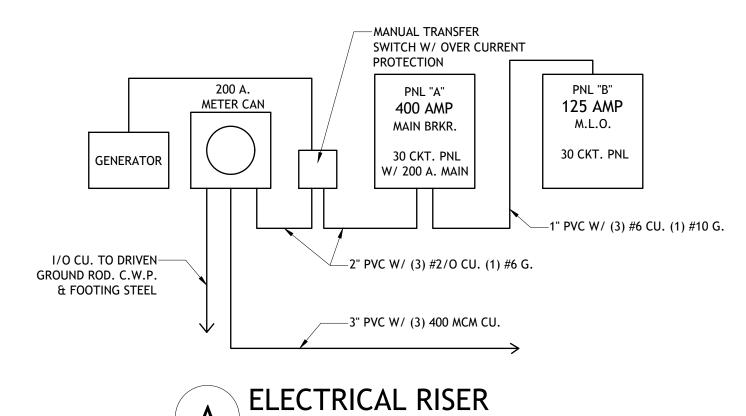

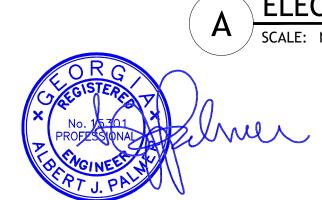

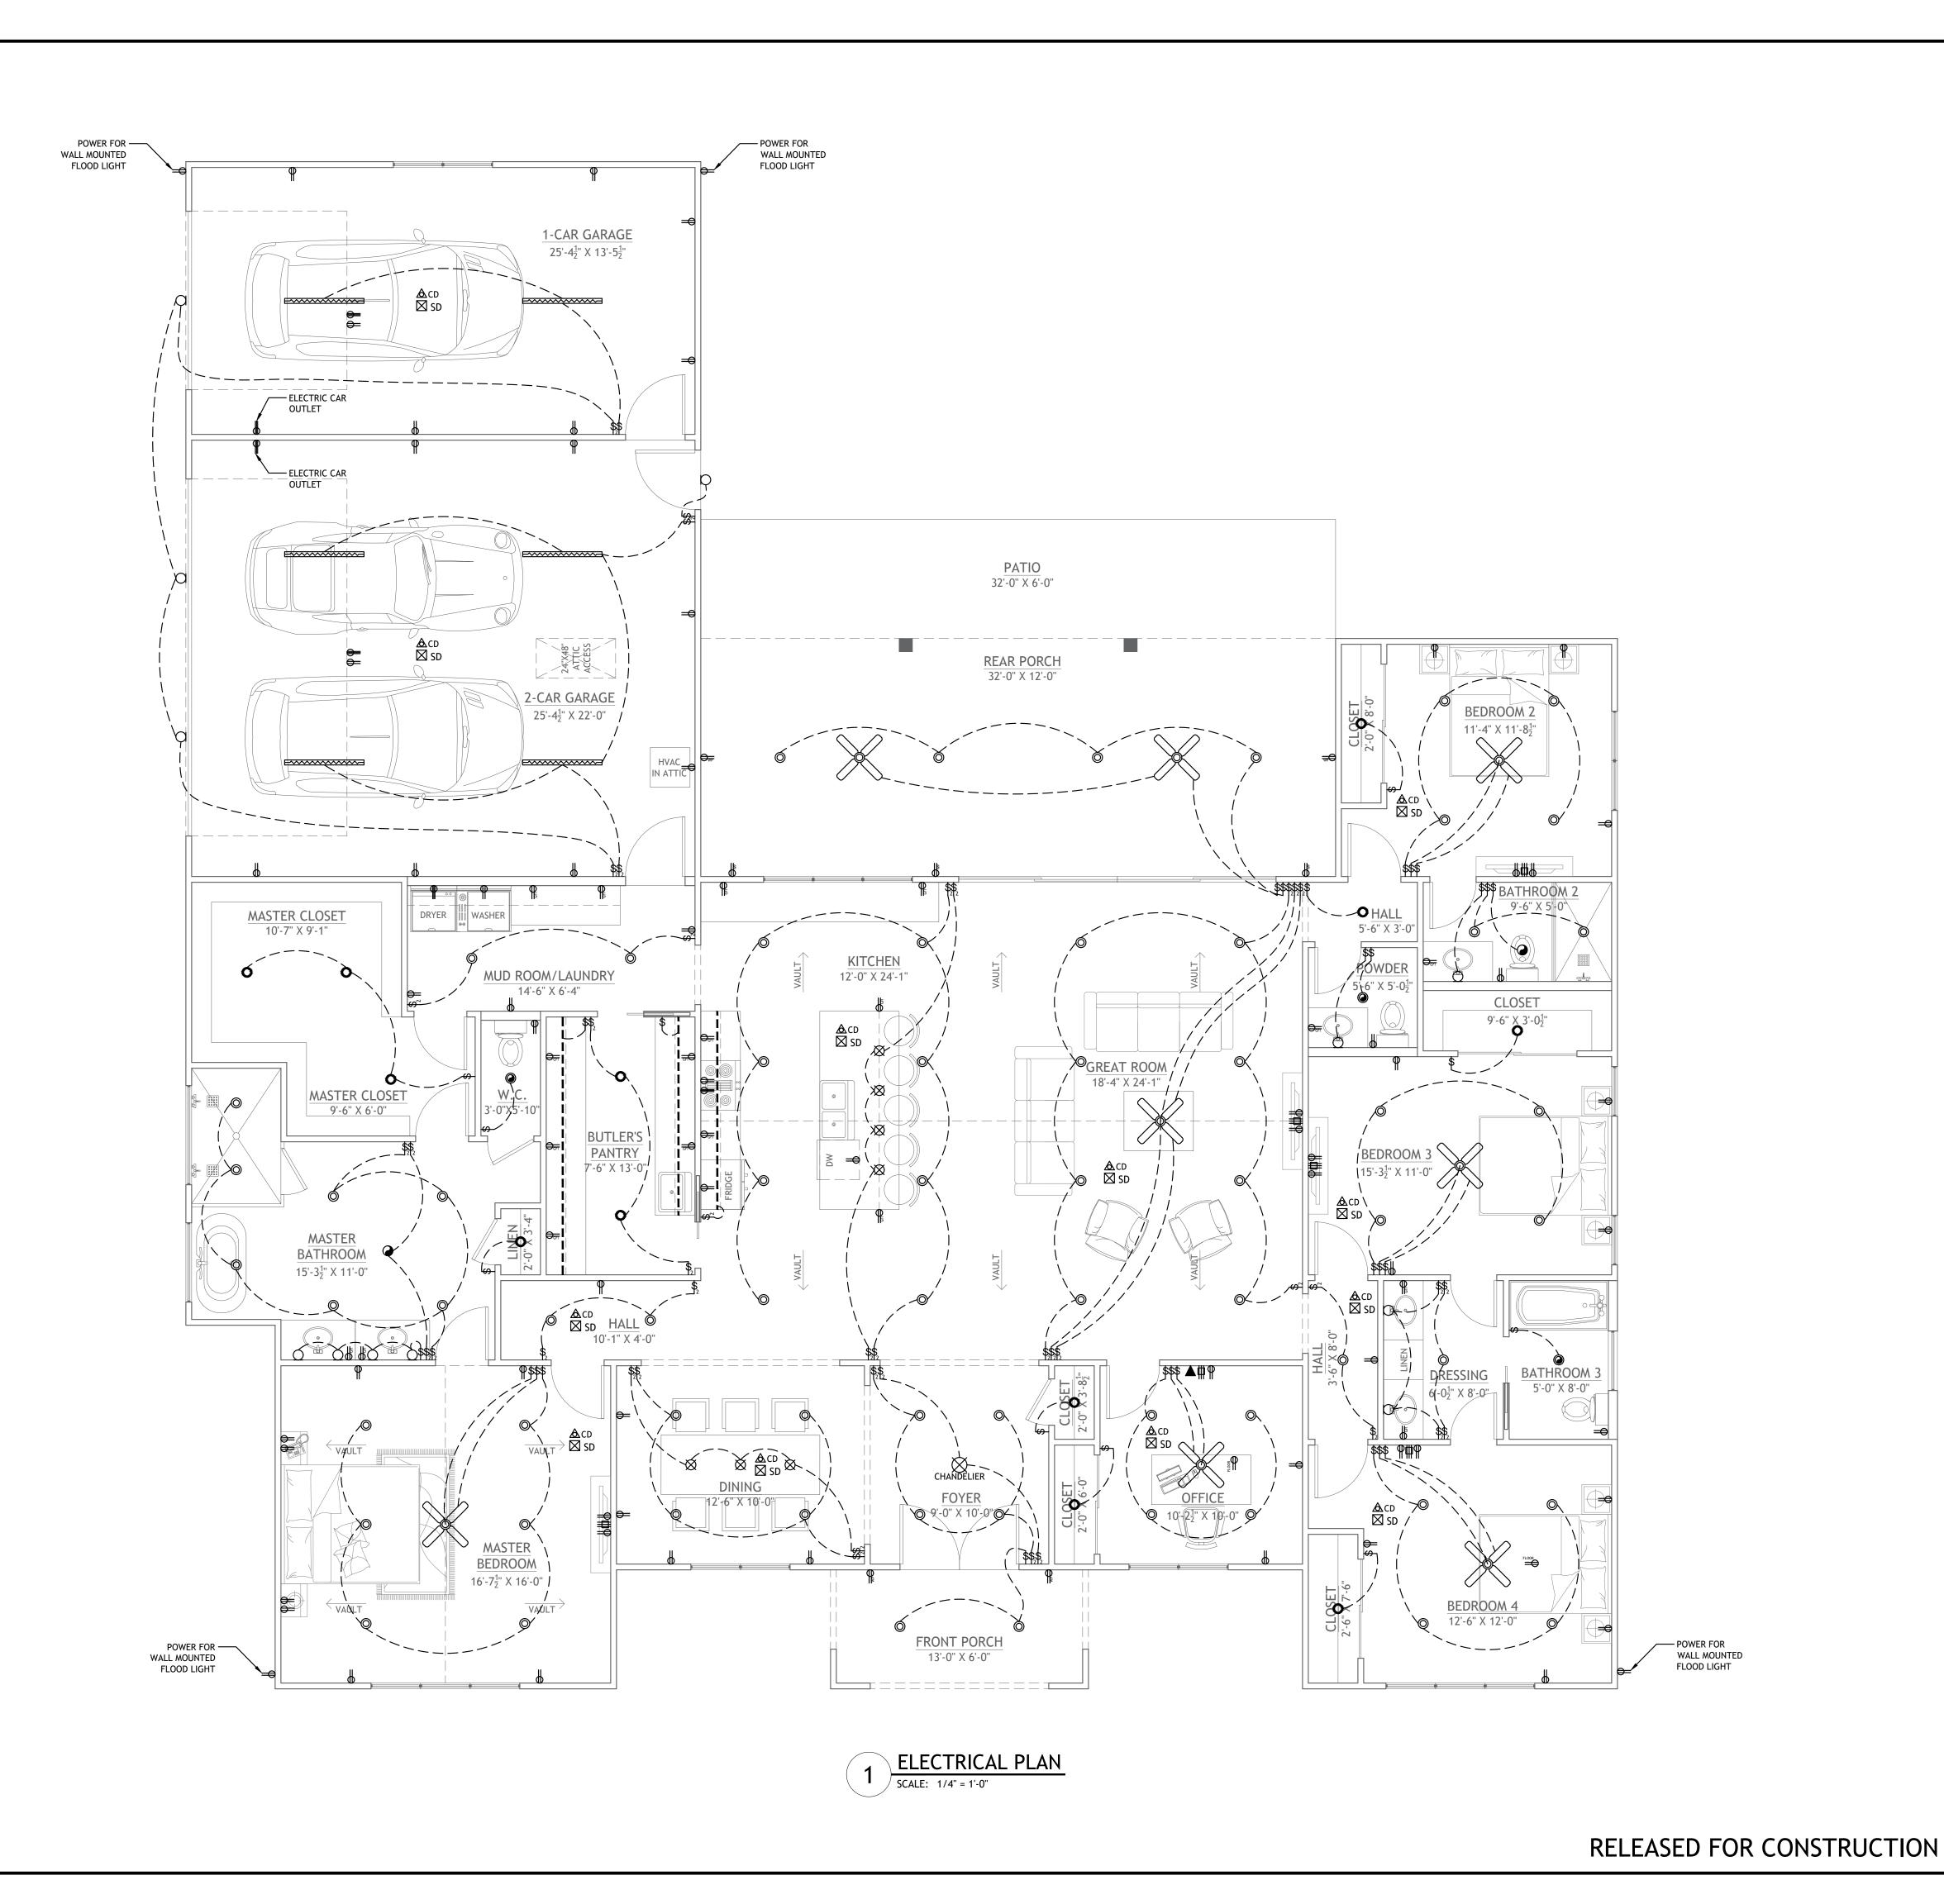

#### PLUMBING NOTES:

- 1. IT IS THE CONTRACTOR'S RESPONSIBILITY TO FIELD VERIFY THE EXACT LOCATION OF ALL UTILITY SERVICES AND SLOPE PRIOR TO
- BID/INSTALLATION. CONTRACTOR SHALL FIELD VERIFY ALL EXISTING CONDITIONS BEFORE COMMENCING WORK AND REPORT ANY AND ALL DISCREPANCIES BETWEEN ACTUAL CONDITIONS AND THESE PLANS TO THE ENGINEER/ARCHITECT IMMEDIATELY.
- CONTRACTOR SHALL MAKE ALL NECESSARY MODIFICATIONS DURING THE CONSTRUCTION PROCESS TO COMPLY WITH I.R.C. (INTERNATIONAL RESIDENTIAL CODE), LATEST
- EDITION, OR APPLICABLE CODES AT SITE. SUGGESTED SLOPE FOR EXTERIOR WASTE LINE @ 1/8"=1'-0".
- 5. ALL YARD CLEANOUTS TO BE CONTRACTOR CHOICE. ALL FIXTURES WILL BE OWNER CHOICE. CALCULATIONS AND CHOICES BASED ON INDUSTRY STANDARDS.
- 6. WASHING MACHINE AND DISHWASHER TO BE
- CUSTOMER'S CHOICE. 7. WATER HEATER TO BE CUSTOMER'S CHOICE.

# PLUMBING LEGEND COLD WATER \_\_\_\_\_CW \_\_\_\_\_

HOT WATER	———HW———
SEWER LINE	SW
GAS LINE	———GAS———

VENT PIPE		
HOSE BIBB		


### FIXTURE CONNECTIONS


CLEAN OUT


		PIPE DIAMETER					
	FIXTURE	SEWER	VENT	COLD WATER	HOT WATER		
	HAND SINK	2"	2"	1/2"	1/2"		
	WATER CLOSET	4"	2"	3/4"	N/A		
	FLOOR DRAIN	3"	2"	N/A	N/A		
	WATER HEATER	N/A	N/A	3/4"	3/4"		
	WASHER/DRYER	2"	N/A	3/4"	3/4"		
	HOSE	N/A	N/A	1/2"	1/2"		
	SINK	2"	2"	1/2"	1/2"		

# NOTE:


- SIZES SHOWN ARE MINIMUM UNIFORM PLUMBING CODE REQUIREMENTS FOR TRAPS, TRAP ARM & ROUGH-IN CONNECTION.
- IF CAST IRON NO-HUB PIPE IS USED, WASTE AND
- VENT PIPE SHALL BE 2" MINIMUM.
  ALL FIXTURES TO HAVE VENTILATION PIPE TO
  CEILING EVEN IF NOT SHOWED ON PLANS.

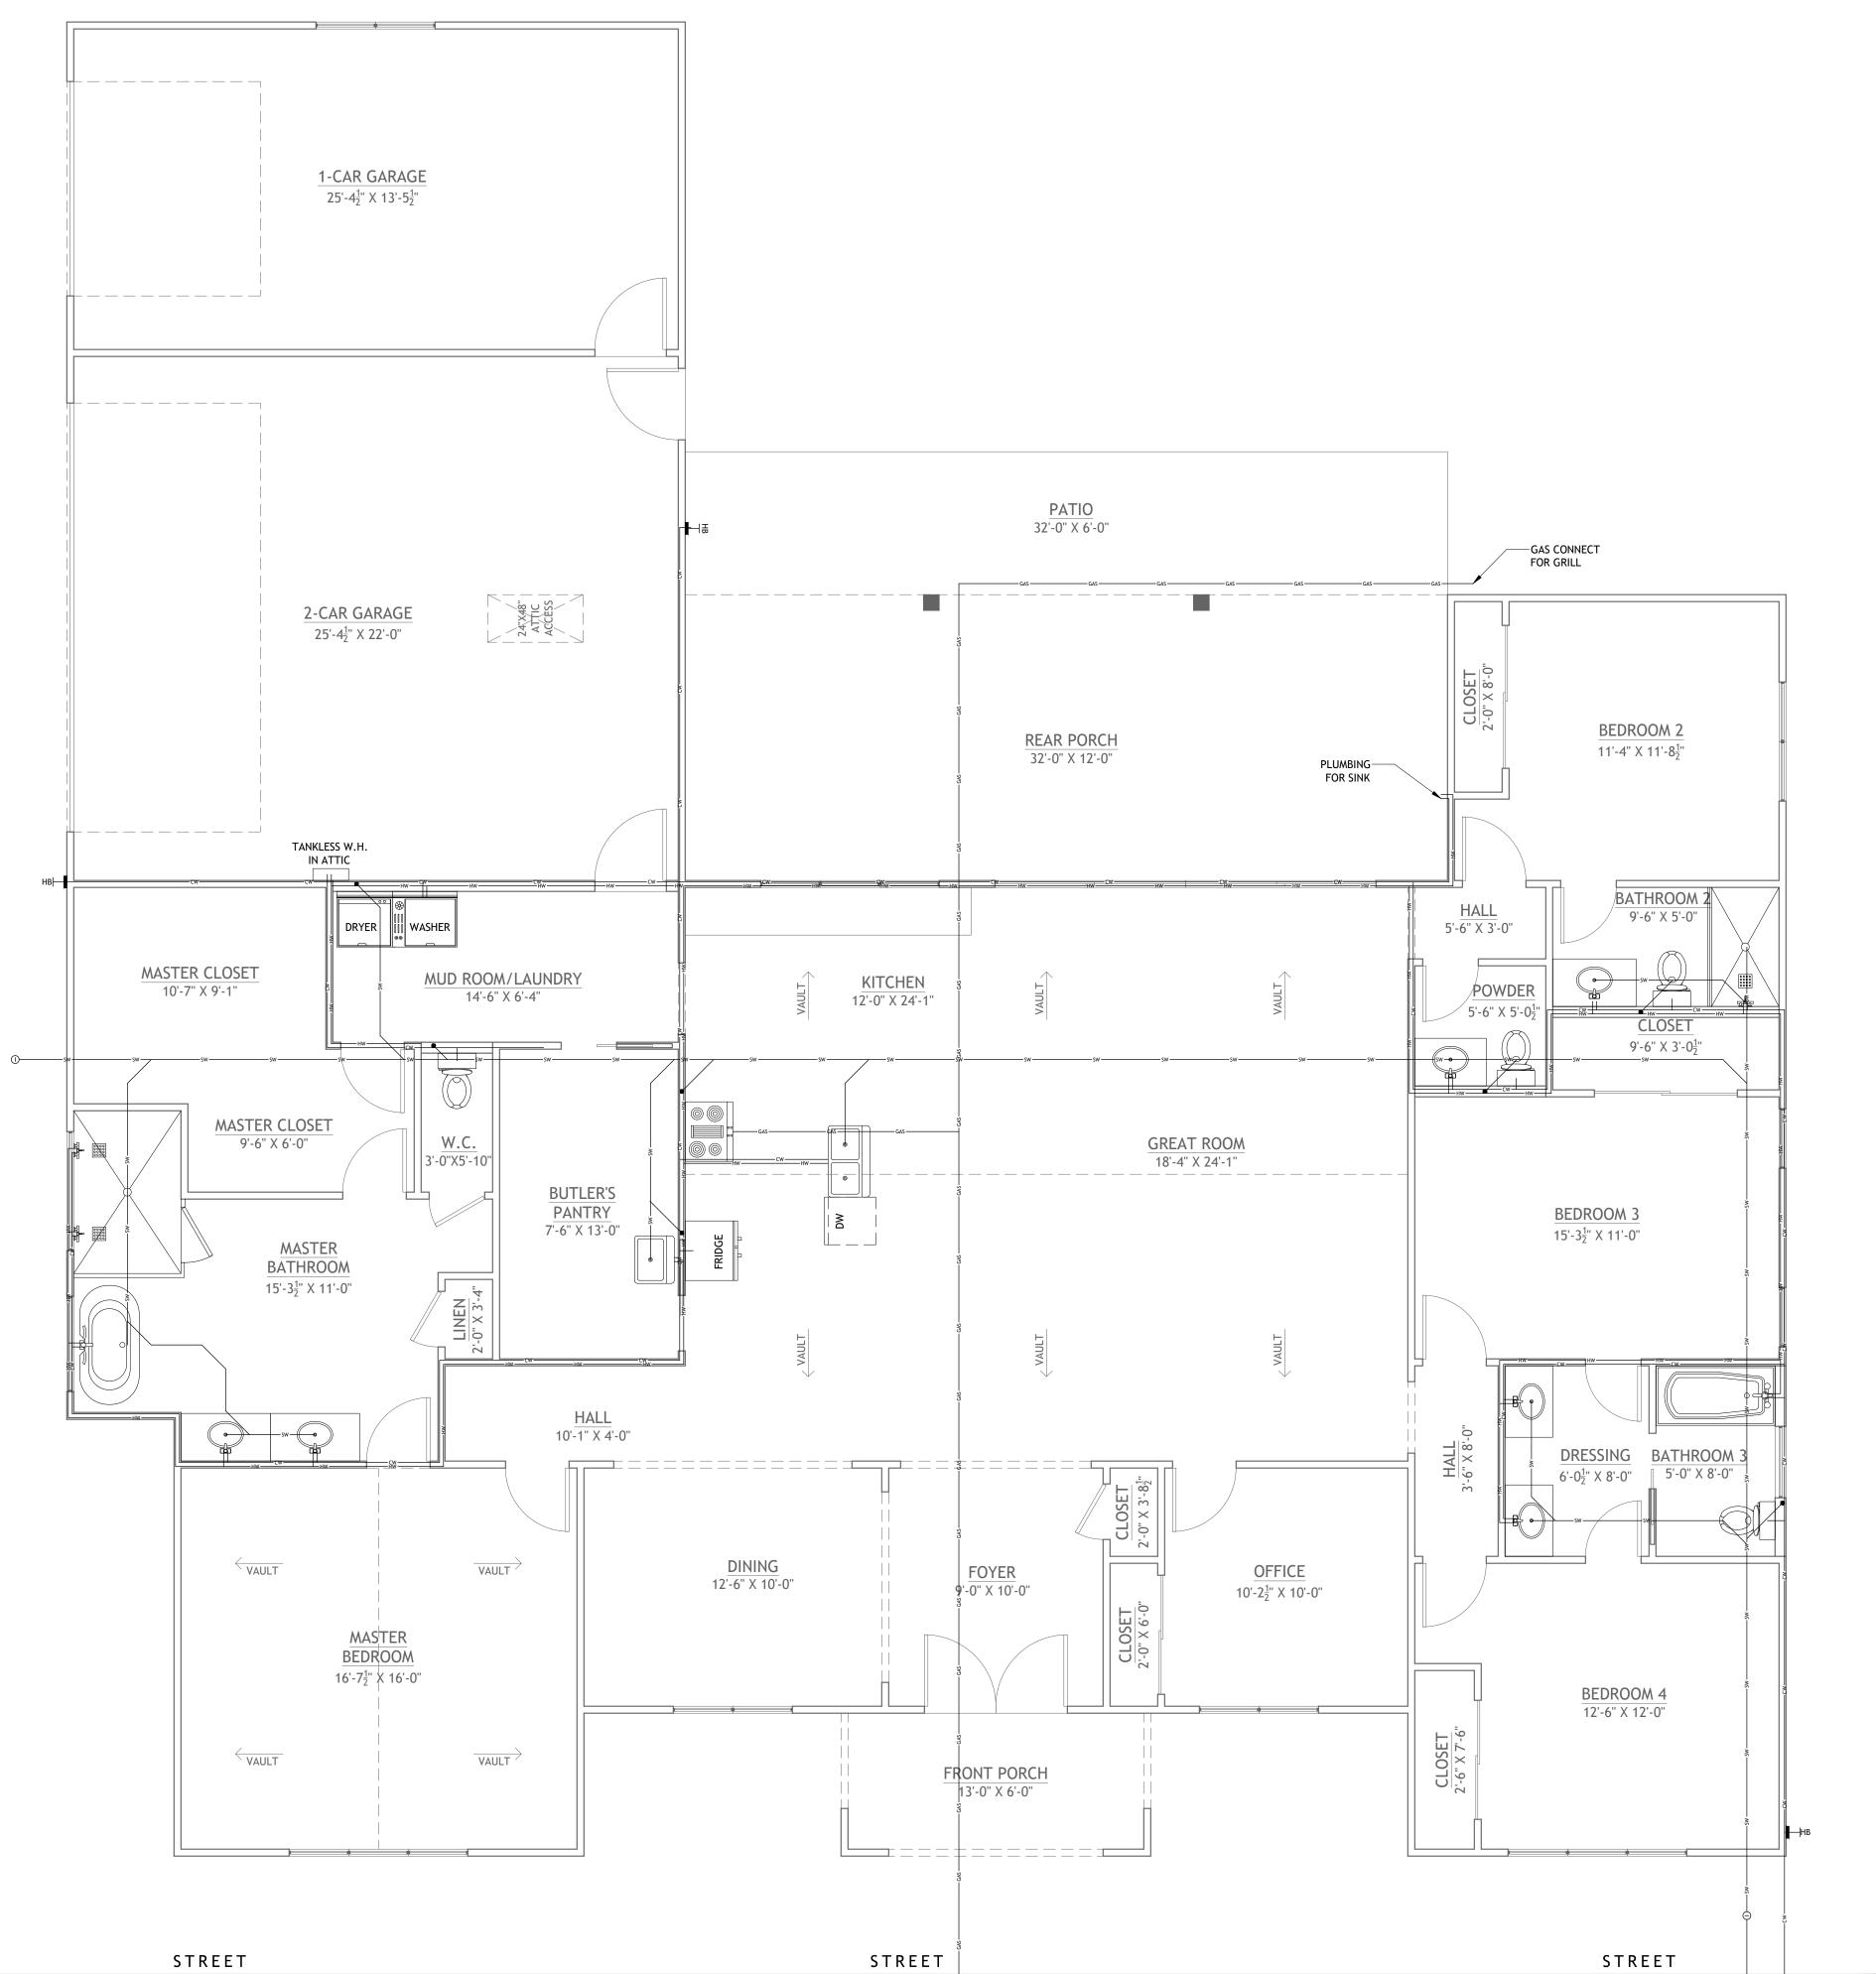

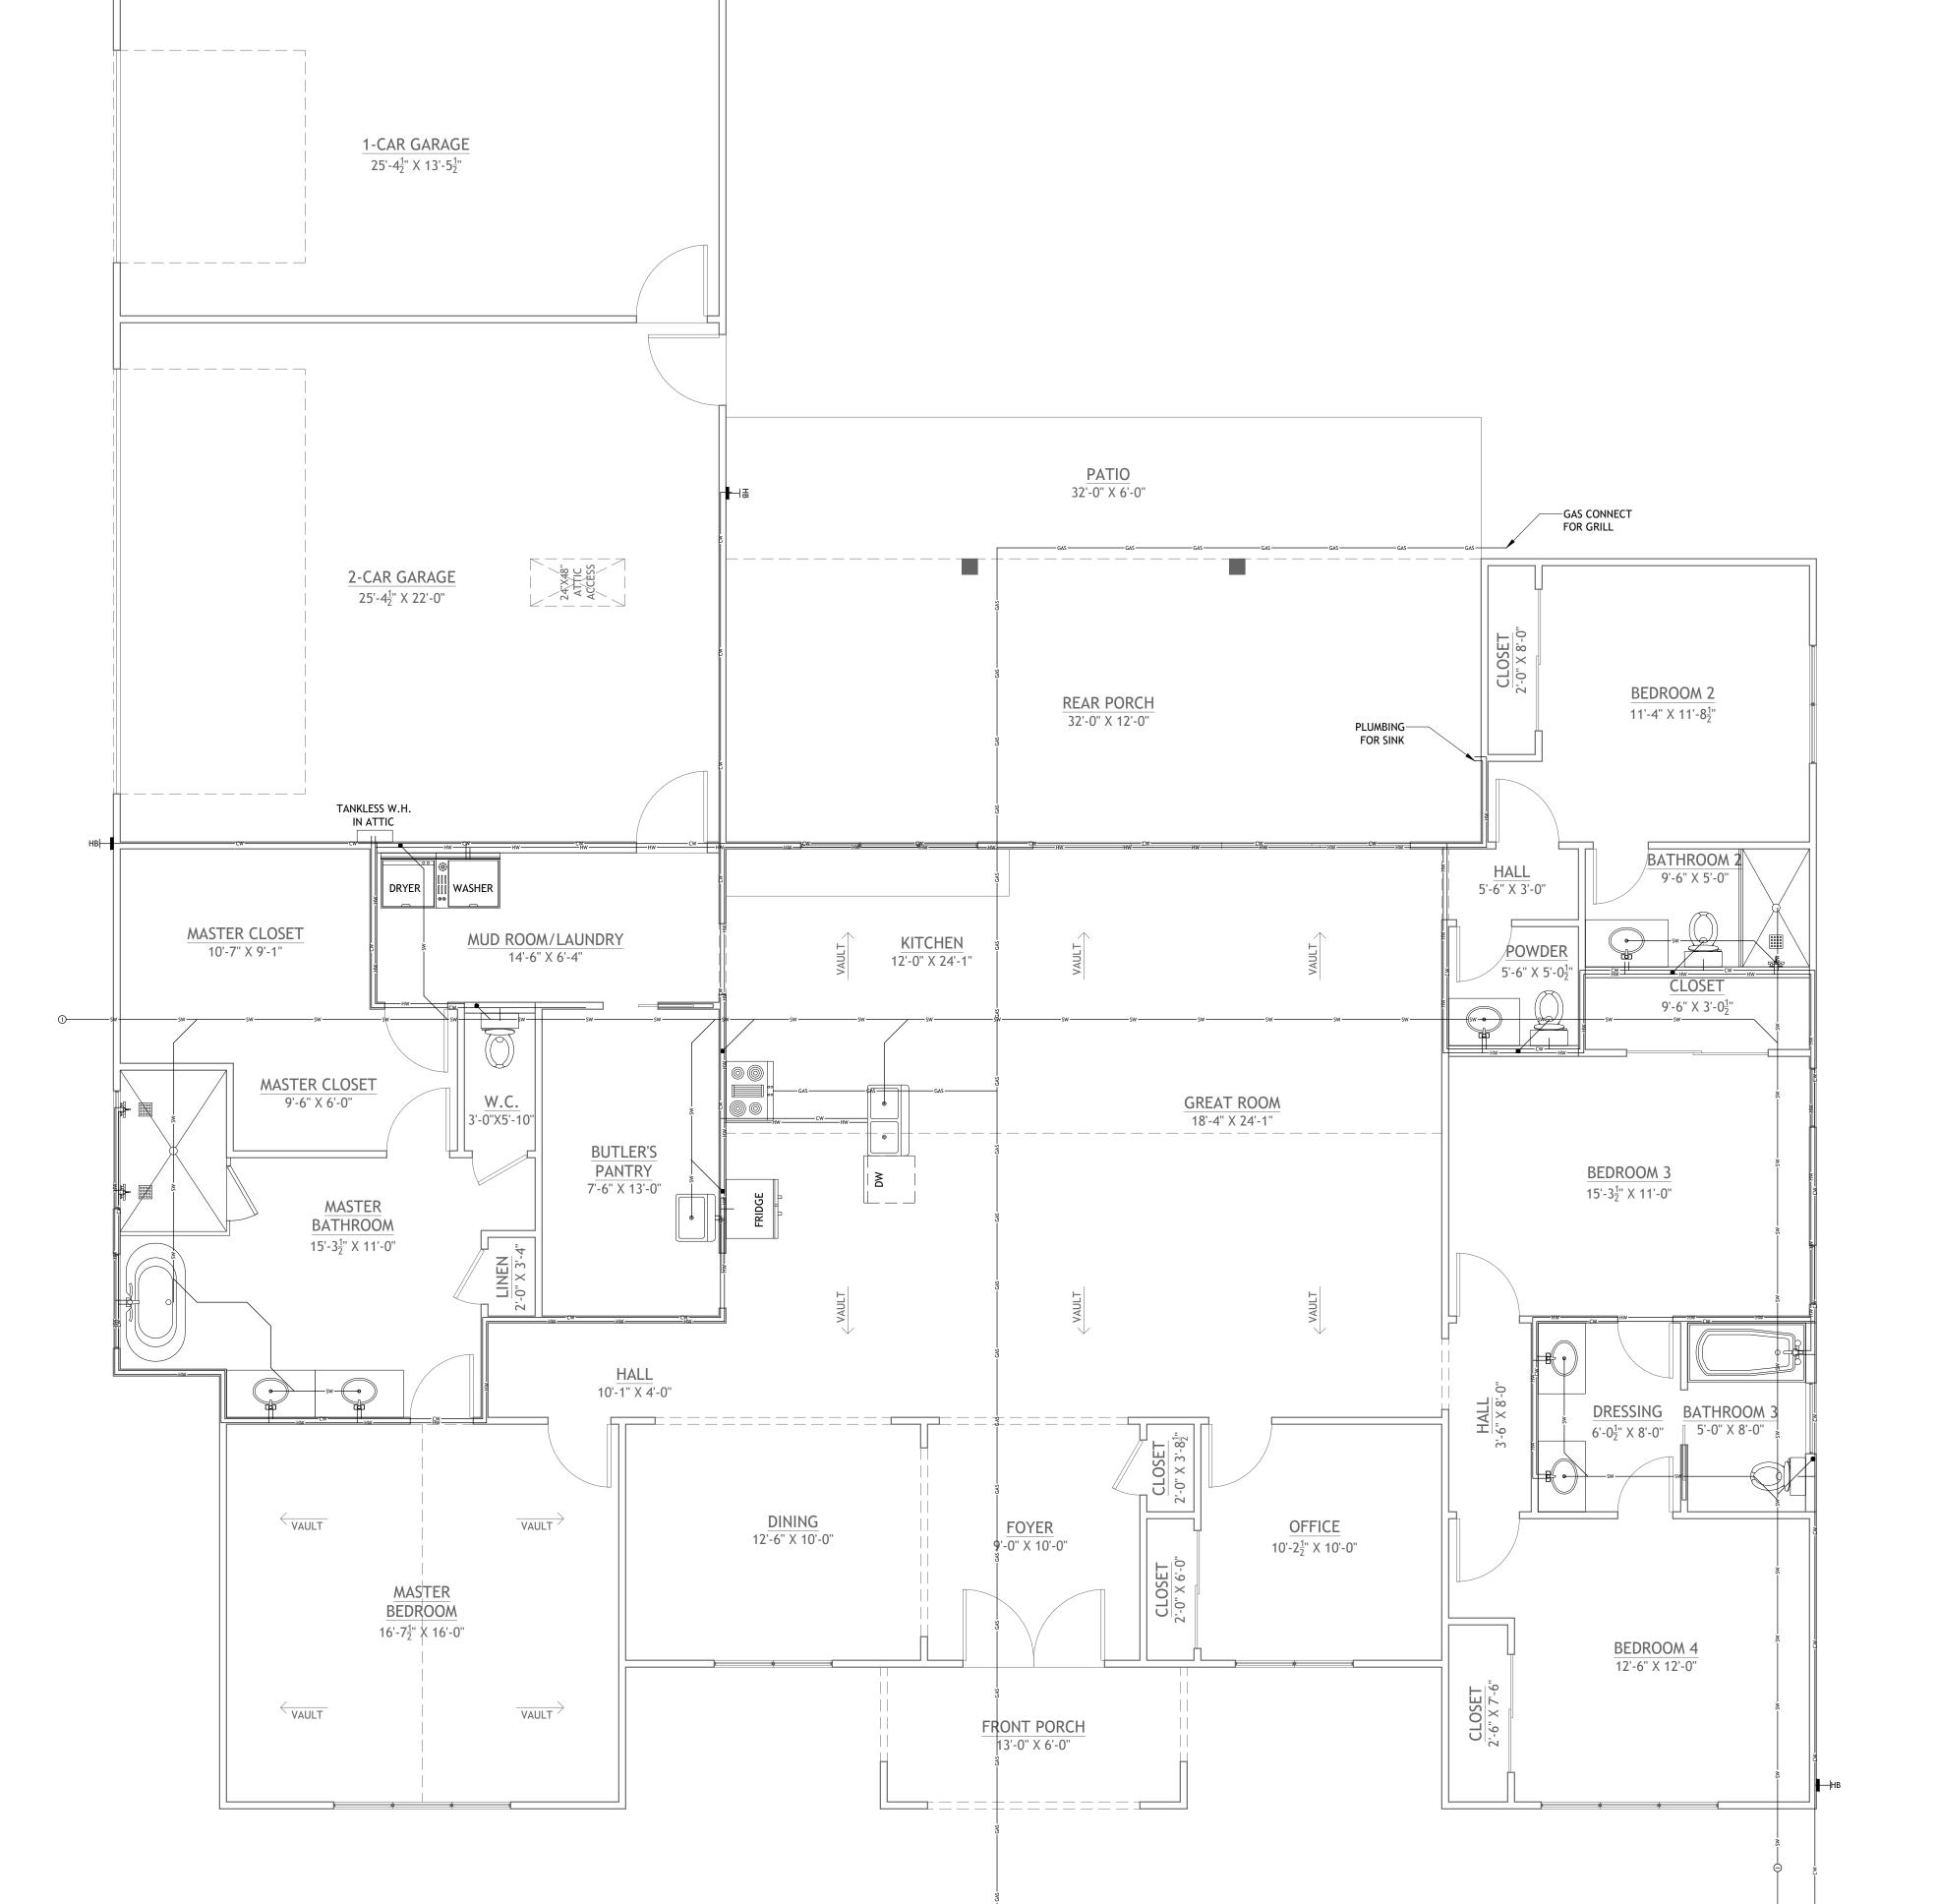


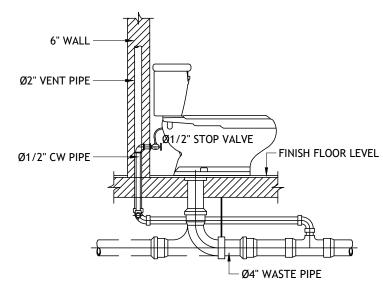


WATER CLOSET DETAIL SCALE: N.T.S.

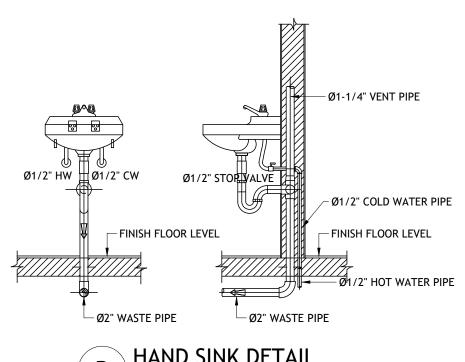


HAND SINK DETAIL (B) SCALE: N.T.S.

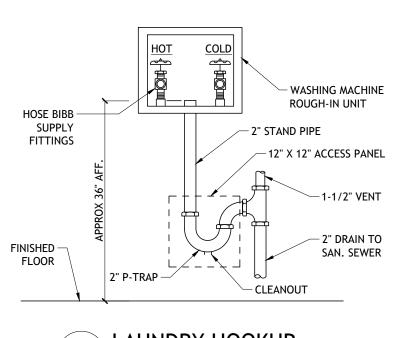


C LAUNDRY HOOKUP
SCALE: N.T.S.

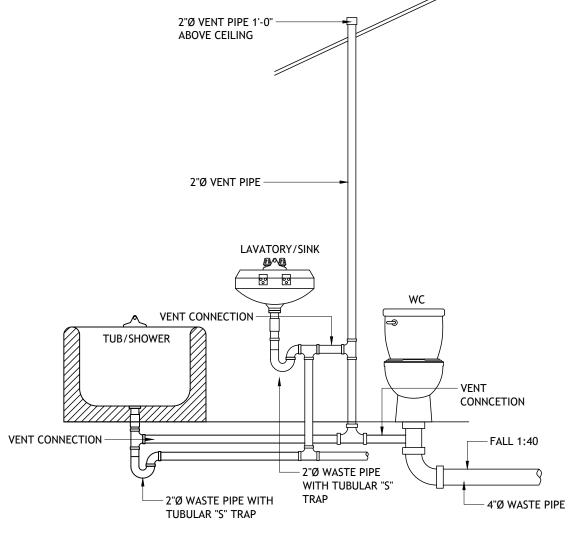

D PLUMBING RISER DETAIL
SCALE: N.T.S.

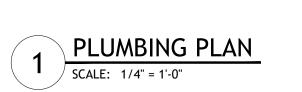

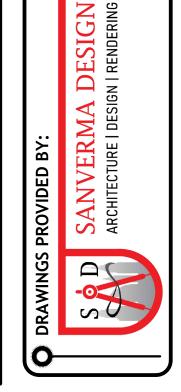

## HVAC NOTES:

- I. IT IS THE CONTRACTOR'S RESPONSIBILITY TO FIELD VERIFY THE EXACT LOCATION OF ALL UTILITY SERVICES AND SLOPE PRIOR
- TO BID/INSTALLATION.
  2. CONTRACTOR SHALL FIELD VERIFY ALL EXISTING CONDITIONS BEFORE COMMENCING WORK AND REPORT ANY AND ALL
- DISCREPANCIES BETWEEN ACTUAL CONDITIONS AND THESE PLANS TO THE ENGINEER/ARCHITECT IMMEDIATELY.

  3. CONTRACTOR SHALL MAKE ALL NECESSARY MODIFICATIONS DURING THE CONSTRUCTION PROCESS TO COMPLY WITH I.R.C. (INTERNATIONAL RESIDENTIAL CODE), LATEST EDITION, OR APPLICABLE CODES AT SITE.
- CONTRACTOR SHALL PROVIDE ALL NECESSARY TRANSITIONS FROM MECHANICAL EQUIPMENT TO DUCTS.
   MECHANICAL CONTRACTOR SHALL COORDINATE WITH OTHER TRADES TO MAINTAIN ACCESS CLEARANCES FOR ALL MECHANICAL
- 5. MECHANICAL CONTRACTOR SHALL COORDINATE WITH OTHER TRADES TO MAINTAIN ACCESS CLEARANCES FOR ALL MECHANICAL EQUIPMENT.
- 6. ALL EXPOSED (VISIBLE) DUCT SHALL BE SHEET METAL SINGLE WALL INTERNALLY LINED TYPE AND SURFACED FOR PAINTING. COLOR SELECTION BY ARCHITECT. (NO EXPOSED FLEX DUCT SHALL BE ALLOWED).
- 7. CONTRACTOR SHALL PROVIDE ACCESS PANELS FOR ALL MECHANICAL EQUIPMENT LOCATED ABOVE INACCESSIBLE CEILINGS.
- 8. ALL EXHAUST AND OUTSIDE AIR DUCTS SHALL BE INSULATED TO PREVENT CONDENSATION AS PER FBC ENERGY C403.2.7.1.3.
  9. OUTSIDE AIR DAMPER FOR UNITS SHALL BE CLOSED WHEN UNITS ARE NOT IN OPERATION. PROVIDE MOTORIZED OR GRAVITY DAMPER AS PER FBC ENERGY C403.2.4.4.
- 10. ALL EXHAUST FANS SHALL BE EQUIPPED WITH BACKDRAFT DAMPERS WHICH CLOSE WHEN THAT FAN IS NOT IN OPERATION.
- PROVIDE MOTORIZED OR GRAVITY DAMPER AS PER FBC ENERGY C403.2.4.4.

  11. CONTRACTOR SHALL COORDINATE ALL ROOF PENETRATIONS AND ROOFING WORK WITH ROOFING CONTRACTOR AS REQUIRED
- TO MAINTAIN ROOF WARRANTY.


  12. PROVIDE VOLUME DAMPERS ON ALL DIFFUSERS (VISIBLE ON PLAN OR NOT).
- 13. REDUCE DUCT 2" MAX. WHERE JOIST CAUSE CONFLICT.
- 14. BUILDING HVAC CALCULATIONS ARE TO BE PROVIDED BY THE MECHANICAL CONTRACTOR.


DU	JCTWORK
DIAMETER	AIR FLOW CFM
4	20
5	50
6	80
7	120
8	170
9	230
10	300
12	500
14	740
16	1050
18	1400
20	1875

HVAC LEGEND	
SUPPLY DUCT (WIDTH/ HEIGHT) RETURN DUCT (WIDTH/ HEIGHT)	XX/XX XX/XX
DUCT W/ SUPPLY DIFFUSER	
DUCT W/ RETURN DIFFUSER OR GRILLE  EXHAUST FAN  AIR DEVICE DESIGNATOR CFM VALUE W/ NECK SIZE  DRYER VENT	EF  A XXX X'Ø
DRYER DUCT	
THERMOSTAT	T
NOTE:	


LOCATION AND NUMBER OF DIFFUSERS, DUCT SIZE, CFM VALUE AND NECK SIZE MAY CHANGE BASED ON SITE CONDITIONS PLANS ARE GENERAL IN NATURE AND LOCAL CODES ARE TO BE FOLLOWED.



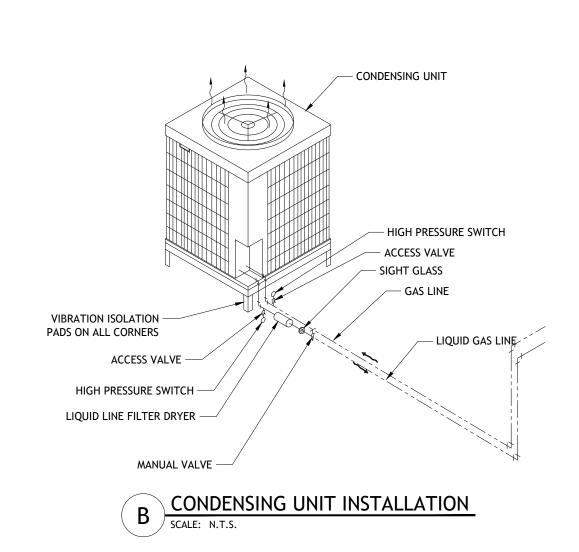

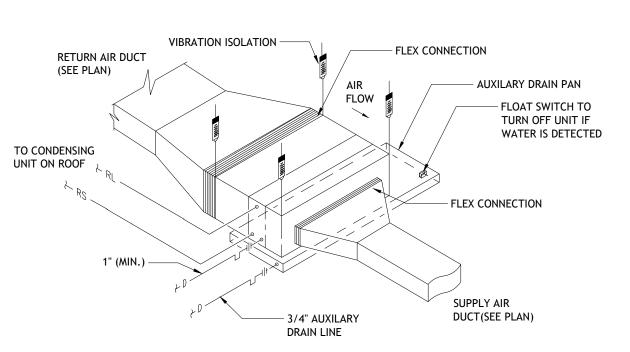

A HORIZONTAL AIR HANDLING UNIT WITH DUCTED DISCHARGE AND RETURN SCALE: N.T.S.

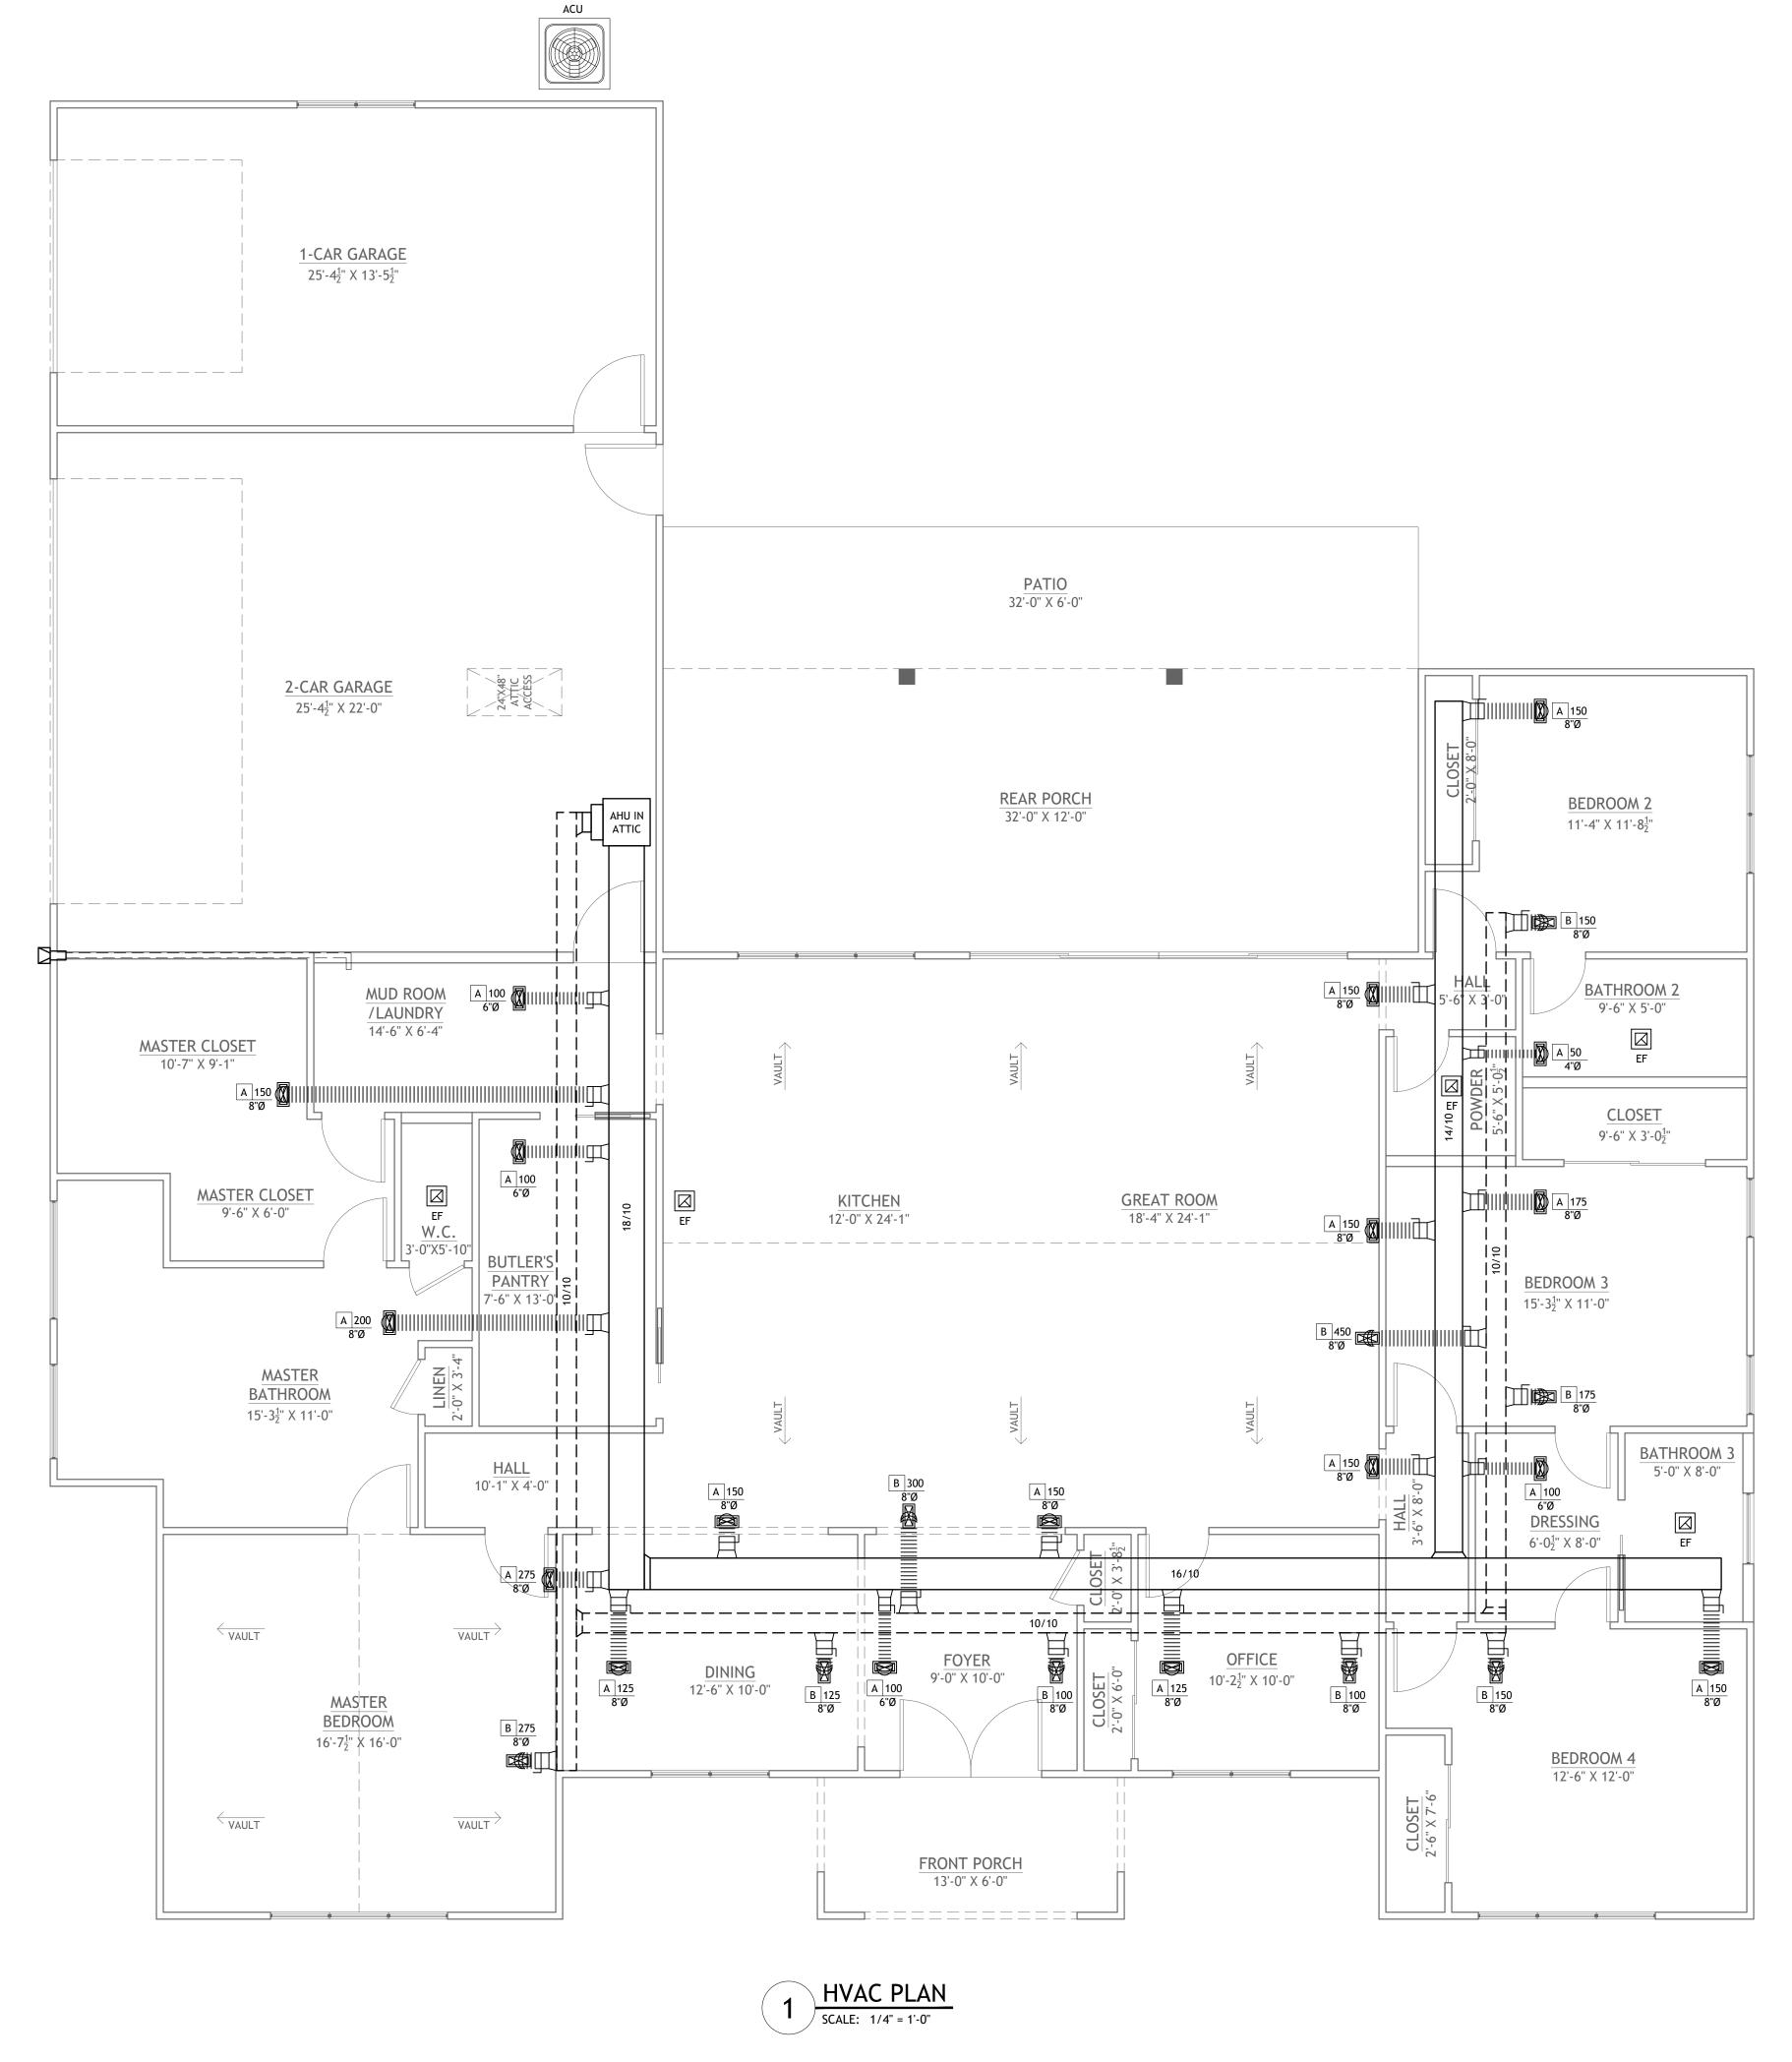




AN1691 EVISION:


O SCALE: 1/4" = 1'-0" @ 24" X 36" O DATE: NOV 9, 24


DANIEL HUMPHRRIES
PROJECT ADDRESS:
2594 CASCADE RD
ATLANTA, GA 30311

O DRAWING TITLE:
HVAC PLAN

HOUGH GREAT EFFORT AND CARE HAVE GONE INTO THE PREPARATION OF THIS HOME IN IT IS IMPOSSIBLE TO AFFECT ANY CONTROL OVER THE ACTUAL CONSTRUCTION. FOR IT REASON AND DUE TO THE MANY JURISDICTIONAL DIFFERENCES IN LOCAL BUILDING OF REQUIREMENTS AND OTHER LOCAL SEISMIC AND WEATHER CONDITIONS, "SANVERMA SENDING STRUCTURAL FAILURES DUE TO ANY DEMAGES, MONETARY OR OTHERWISE, LUDING STRUCTURAL FAILURES DUE TO ANY DEFICIENCIES, OMISSIONS, OR ERRORS IN EDESIGN. HOME PLANS ARE GENERAL IN NATURE. IT IS THE RESPONSIBILITY OF THE NER AND BUILDER TO CONSULT A LOCAL ARCHITECT OR ENGINEER AND TO CHECK WITH "ALB BUILDING OFFICIALS BEFORE THE START OF CONSTRUCTION. ADDITIONAL

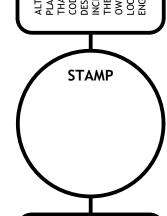

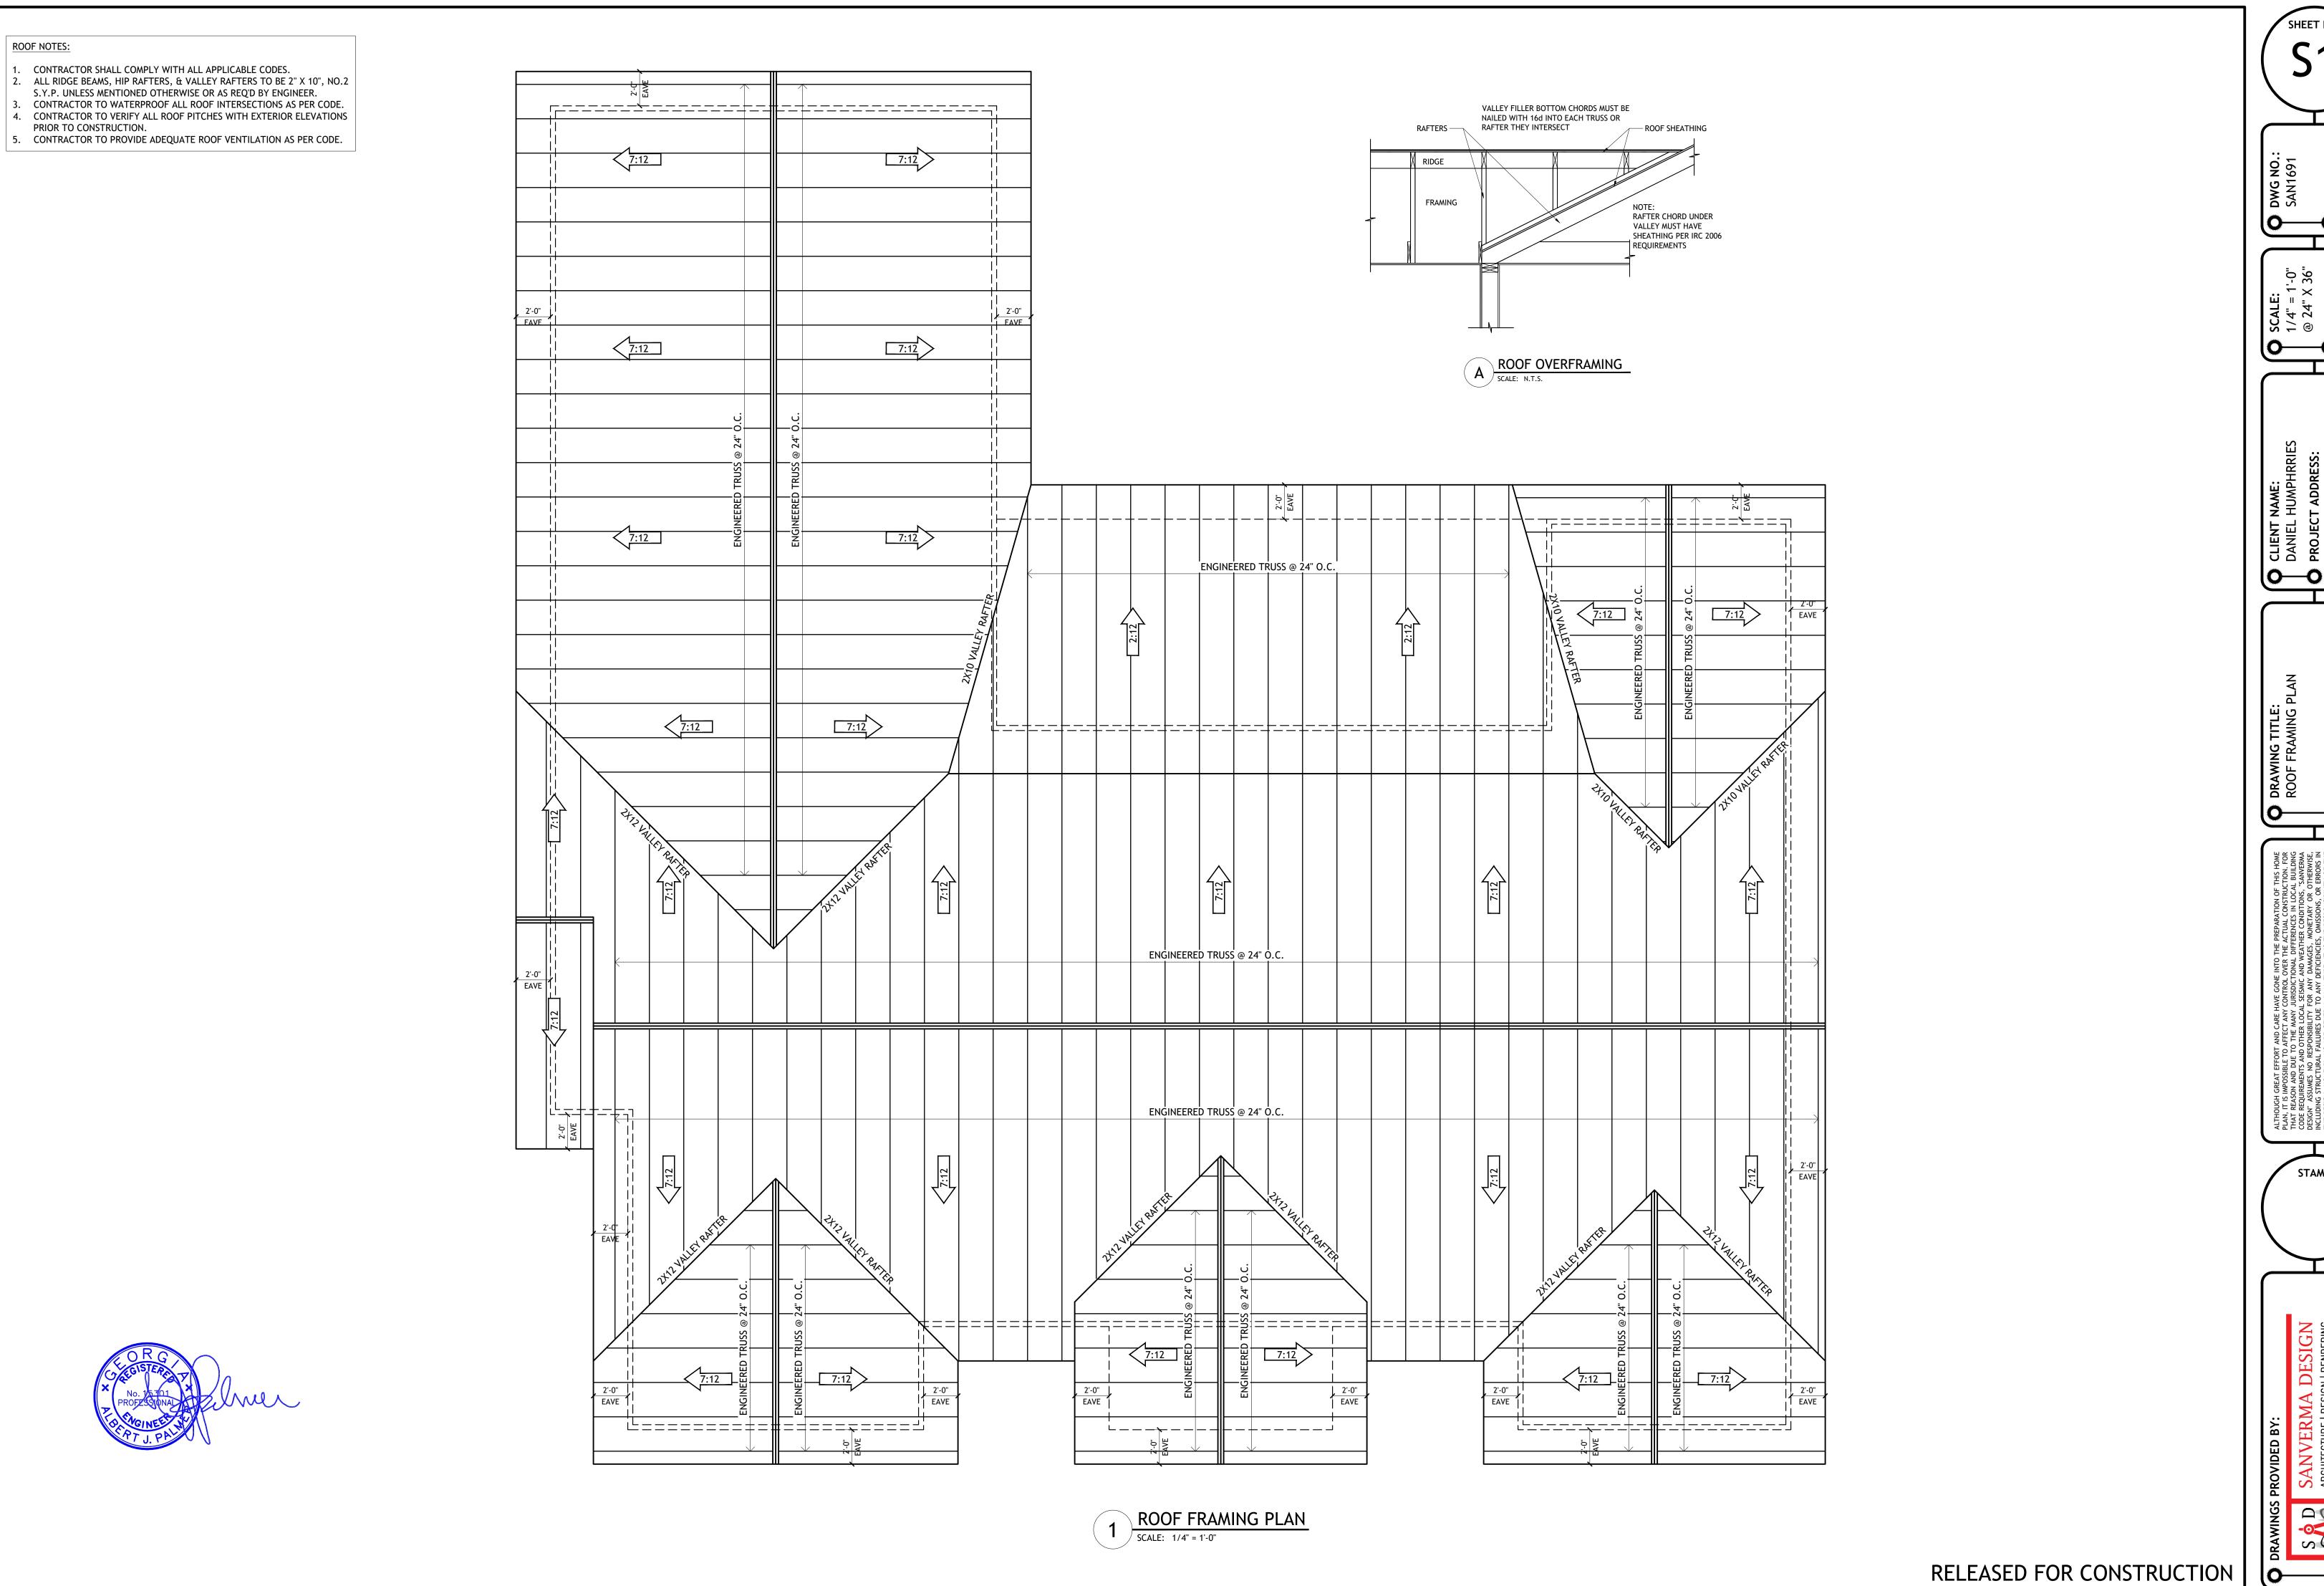

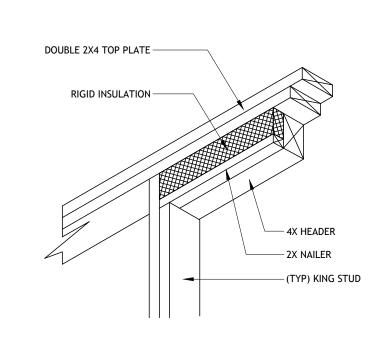


# EXTERIOR HEADER DETAIL

HEADERS #2 D.F. OR BETTER


UP TO 4' 4X8 4' TO 6' 4X10 6' TO 8' 4X12 OVER 8' AS DETAILED


# INTERIOR & EXTERIOR HEADER SCHEDULE


A HEADER DETAIL AND SCHEDULE
SCALE: N.T.S.

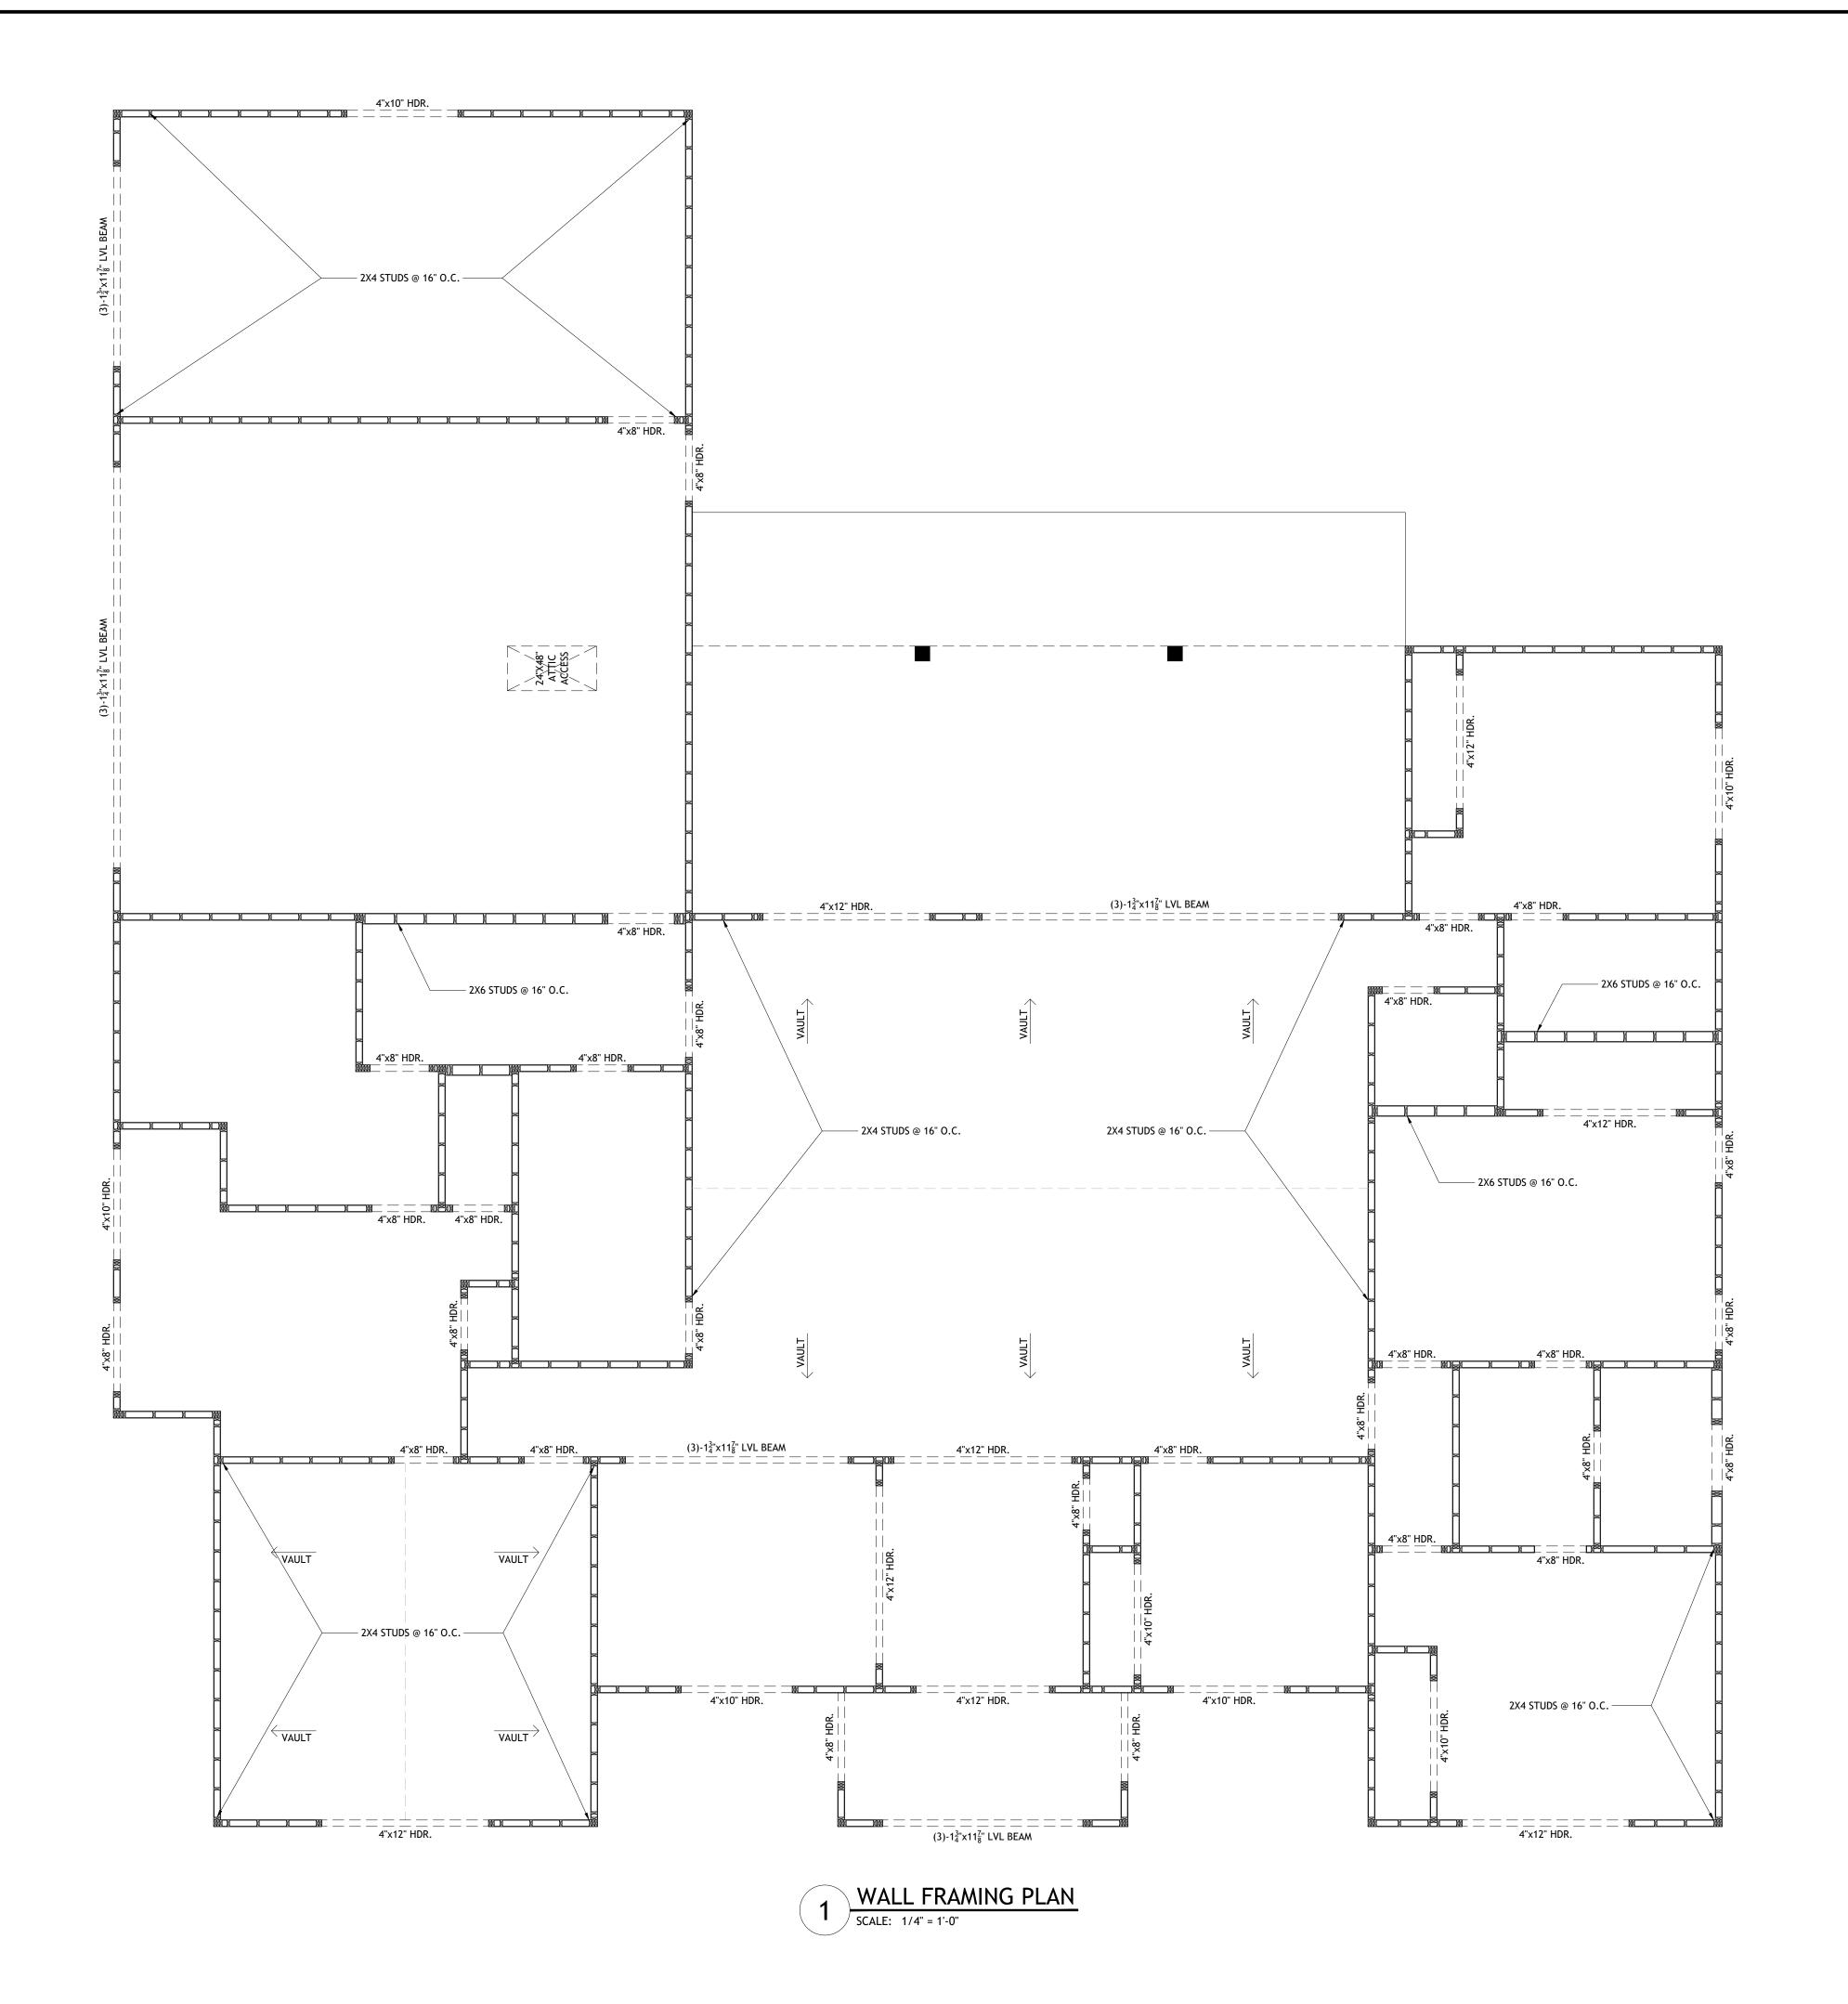




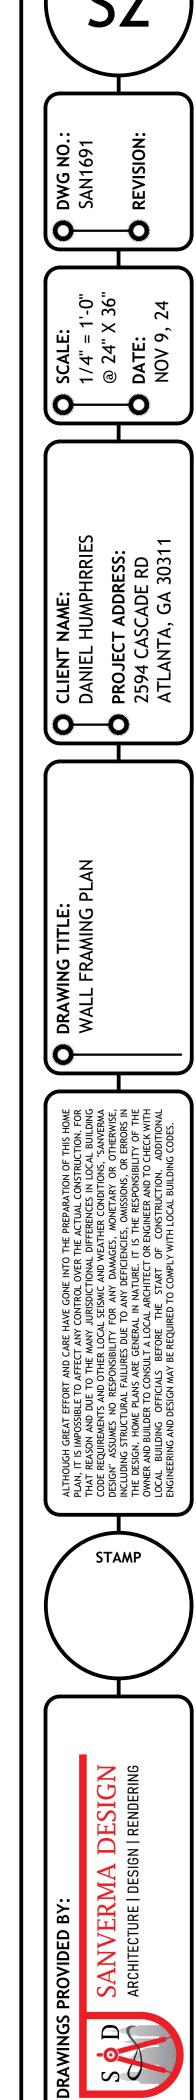

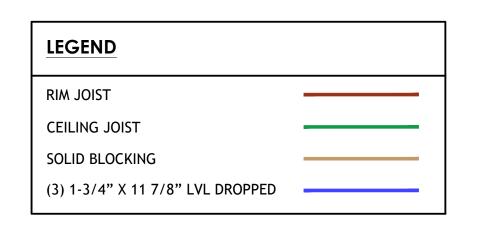

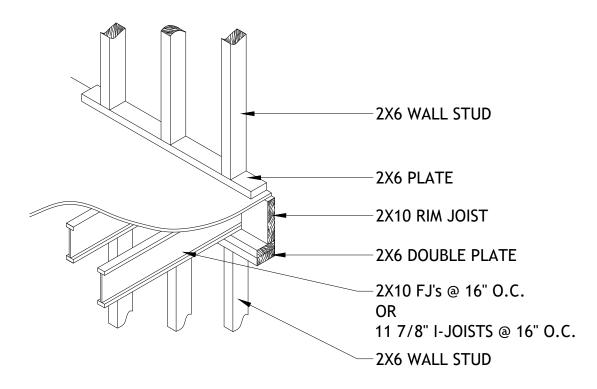


# A FLOOR FRAMING AT EXTERIOR WALL SCALE: N.T.S.

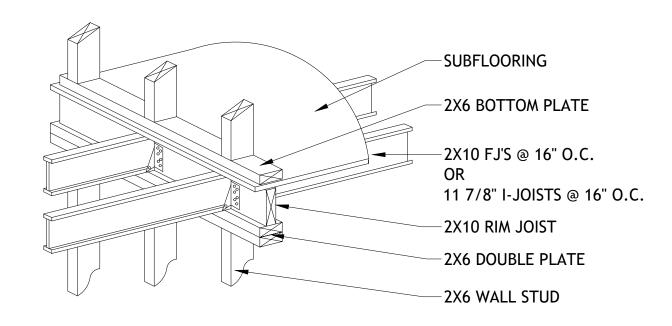

# B LOAD BEARING WALL AND FRAMING SCALE: N.T.S.


CEILING		OUTHERN PINE SPECIES (UNINHABITABLE ATTIC WITHOUT STORAGE, OAD = 20PSF, $L/\Delta$ = 240) DEAD LOAD = 10 PSF
**IF HA	BITABLE ATTIC SPAC	E OR STORAGE IS DESIRED, REFER TO INTERNATIONAL RESIDENTIAL CODE SPAN TABLES
SIZE	SPACING (INCHES)	VISUALLY GRADED #2 SOUTHERN PINE (MAXIMUM CEILING JOIST SPAN) (FTIN.)
	12.0	9-3
2" 4"	16.0	8-0
2"x4"	19.2	7-4
	24.0	6-7
	12.0	13-11
2"x6"	16.0	12-0
2 X6	19.2	11-0
	24.0	9-10
	12.0	17-7
2"x8"	16.0	15-3
2 X6	19.2	13-11
	24.0	12-6
	12.0	20-11
2"x10" -	16.0	18-1
Z X I U	19.2	16-6
	24.0	14-9



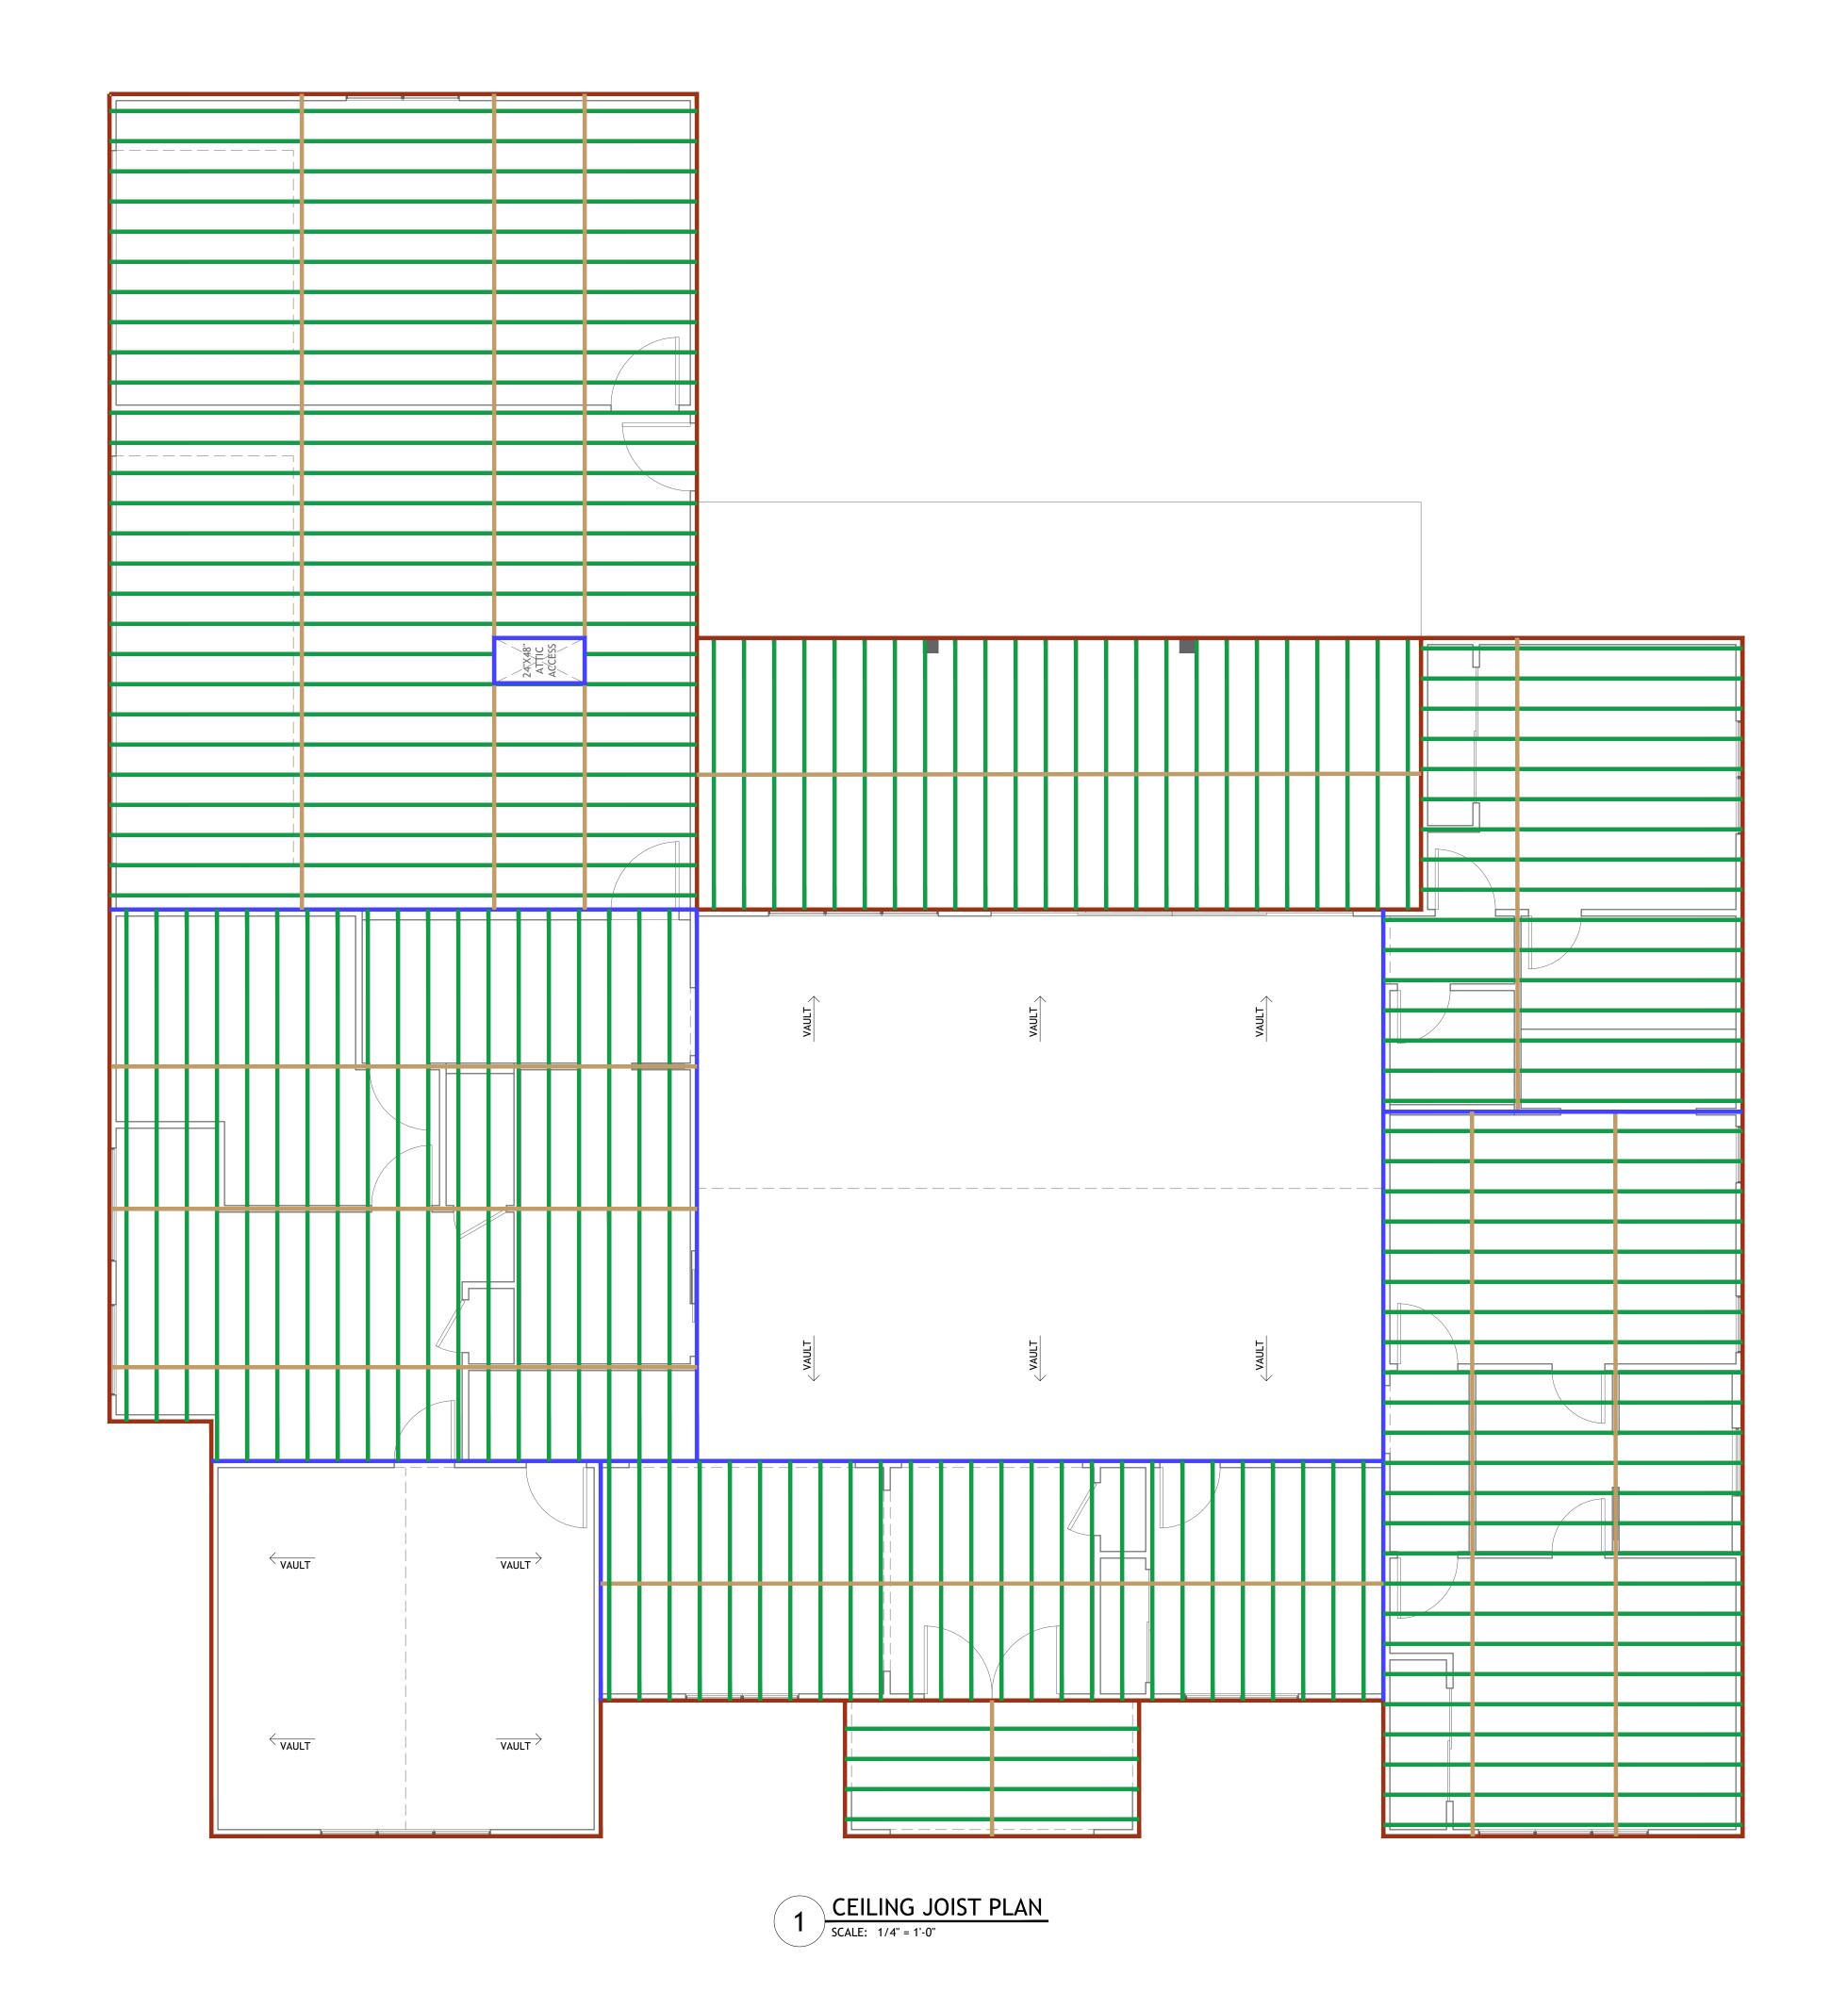


# FOUNDATION NOTES: IT IS THE CONTRACTOR'S RESPONSIBILITY TO FIELD VERIFY THE EXACT LOCATION OF ALL UTILITY SERVICES AND SLOPE PRIOR TO BID/INSTALLATION. CONTRACTOR SHALL FIELD VERIFY ALL EXISTING CONDITIONS BEFORE COMMENCING WORK AND REPORT ANY AND ALL DISCREPANCIES BETWEEN ACTUAL CONDITIONS AND THESE PLANS TO THE ENGINEER/ARCHITECT IMMEDIATELY. CONTRACTOR SHALL MAKE ALL NECESSARY MODIFICATIONS DURING THE CONSTRUCTION PROCESS TO COMPLY WITH I.R.C. (INTERNATIONAL RESIDENTIAL CODE), LATEST EDITION, OR APPLICABLE CODES AT SITE. SEE ARCHITECTURAL DRAWINGS FOR CONCRETE SLAB ELEVATIONS, SLOPE DEPRESSIONS, SLOPES, OPENINGS, CURBS, DRAINS, TRENCHES, SLAB EDGE LOCATIONS, ETC., AND FOR WALL OVERALL DIMENSIONS, LOCATIONS OF OPENINGS, ETC., NOT INDICATED ON STRUCTURAL DRAWINGS. VERIFY ALL DIMENSIONS WITH ARCHITECTURAL DRAWINGS PRIOR TO COMMENCING THE WORK. ALL DIMENSIONS SHALL BE VERIFY IN FIELD PRIOR TO COMMENCING ANY DEMOLITION. FOR FOUNDATION/SOIL/DRAINAGE SPECIFICATION REFER TO SOIL GEOTECHNICAL REPORT. FOUNDATION PLANS AND PERTINENT DETAILS SHALL BE REVIEWED AND APPROVED BY THE SOILS ENGINEER PRIOR TO ANY FOUNDATION WORK. SOIL REPORT SHALL BE TAKEN PRECEDENCE OVER STRUCTURAL NOTES AND DETAILS. SITE GRADING, SUBGRADE PREPARATION, EXCAVATION, AND PLACEMENT OF ENGINEERED FILL MATERIAL SHALL BE PERFORMED IN ACCORDANCE WITH THE SOIL REPORT AND GRADING PLANS. ALL EXCAVATION AND PLACEMENT OF ENGINEERED FILL SHOULD BE OBSERVED AND APPROVED -5" THICK CONC. SLAB ON-GRADE BY THE SOILS ENGINEER BEFORE PLACEMENT OF REBAR. (3000 PSI) WITH #3 REBAR @ 16" SURFACE OUTSIDE THE HOUSE NEEDS TO HAVE 5% SLOPE (UNPAVED O.C. OVER COMPACTED SELECT SURFACE) & 2% SLOPE (PAVED SURFACE) AWAY FROM THE STRUCTURE. FILL MATERIAL 10. ALL FOOTING SIZES AND LOCATIONS TO BE VERIFIED BY A LICENSED STRUCTURAL ENGINEER. FF = +5" 11. CONTRACTOR TO ADAPT PLANS AS REQUIRED TO MEET ALL APPLICABLE 32'-0" CODES AT SITE. 12. CONTRACTOR TO PROVIDE WATERPROOFING AS REQUIRED TO MEET ALL APPLICABLE CODES AND TYPICAL BUILDING PRACTICES. 13. CONCRETE SLABS TO BE 4" (3000 PSI MIN.), REINFORCED AS PER CODE OR AS DETERMINED BY LICENSED ENGINEER. L \_ + \_ \_ \_ \_ \_ \_ \_ \_ \_ \_ <del>\</del> \_ - \ 14. CONTRACTOR TO PROVIDE ADEQUATE DRAINAGE BASED ON EXISTING SITE CONDITIONS. VERIFY W/LOCAL CODES. 15. REFER TO FLOOR JOIST MANUFACTURER FOR JOIST SIZING AND SPACING, CROSS BRACING REQUIREMENTS, AND BEAM SIZES. 16. PROVIDE JOISTS UNDER ALL WALLS RUNNING PARALLEL. SPECIFICATION NOTES REINFORCED CONCRETE SHALL CONFORM TO APPLICABLE REQUIREMENTS OF THE 2012 I.R.C. AND ALL LOCAL CITY OR COUNTY GUIDELINES. ALL CONCRETE USED IN THE FOUNDATIONS AND SLABS ON GRADE SHALL HAVE A 28 DAY COMPRESSIVE STRENGTH OF NOT LESS THAN 3,000 PSI. THE MAXIMUM SLUMP SHALL NOT EXCEED 4 INCHES. PROVIDE CONTROL JOINTS IN ALL EXPOSED SLABS ON GRADE. THE MAXIMUM SPACING OF CONTROL JOINTS SHALL BE 20" O.G., UNLESS OTHERWISE NOTED. A CIVIL ENGINEER SHOULD BE CONSULTED TO VERIFY FOUNDATION PLANS AND DETAILS. SITE DRAINAGE: IT IS RECOMMENDED THAT THE DRAINAGE BE WELL DEVELOPED. SURFACE WATER SHOULD BE DIRECTED AWAY FROM THE FOUNDATION SOILS. (USE A MINIMUM SLOPE OF 2% WITHIN 10 FEET OF THE FOUNDATION. NO PONDING OF SURFACE WATER SHALL BE ALLOWED NEAR THE STRUCTURE DURING OR AFTER COMPLETION OF THE CONSTRUCTION AND THE LANDSCAPING. THE BUILDER SHALL ADVISE THE OWNER OF THE SITE DRAINAGE REQUIREMENTS. \_5" THICK CÒNC. SLAB ON-GRADE \_(3000 PSI) WITH #3 REBAR @ 16" O.C. OVER COMPACTED SELECT FILL MATERIAL \_\_\_\_\_\_ L \_ \_ \_ \_ \_ \_ \_ \_ \_ \_ \_ \_ <del>\ \_</del> \_ \_\_\_\_\_ 13'-2<del>1</del>" 14'-6<del>1</del>" 1'-0" 13'-0" FOUNDATION PLAN

RELEASED FOR CONSTRUCTION

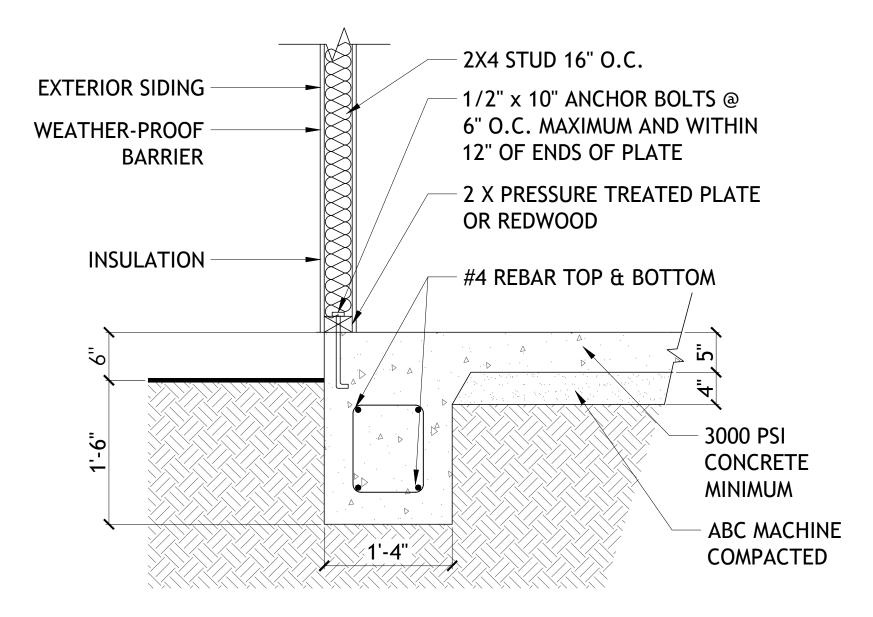




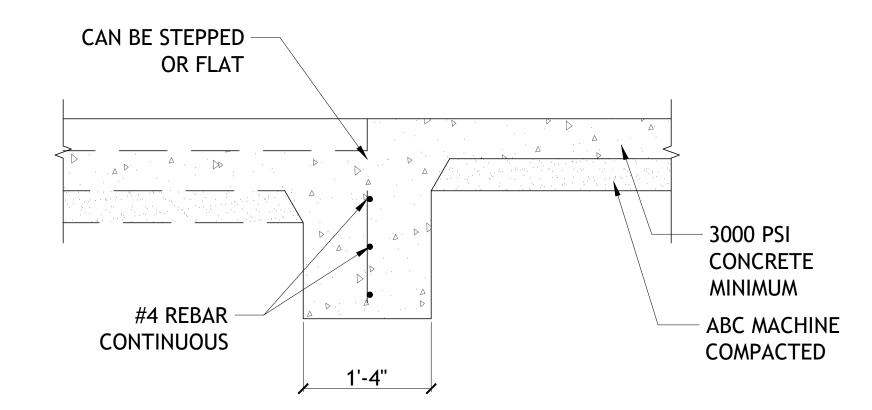


2 INTERIOR BEARING FOOTING

SCALE: 1" = 1'-0"

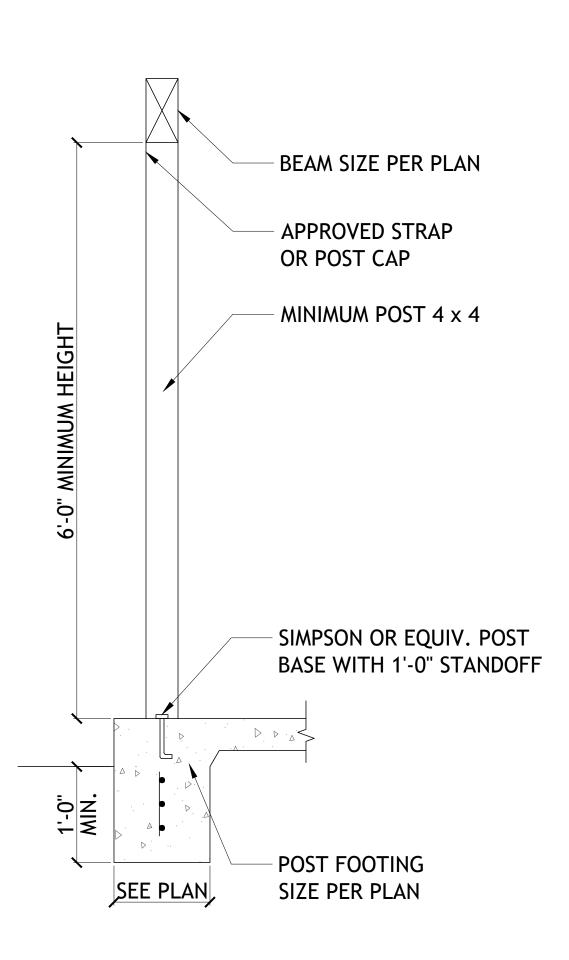



3 C-TYPICAL COLUMN DETAIL

SCALE: 1" = 1'-0"

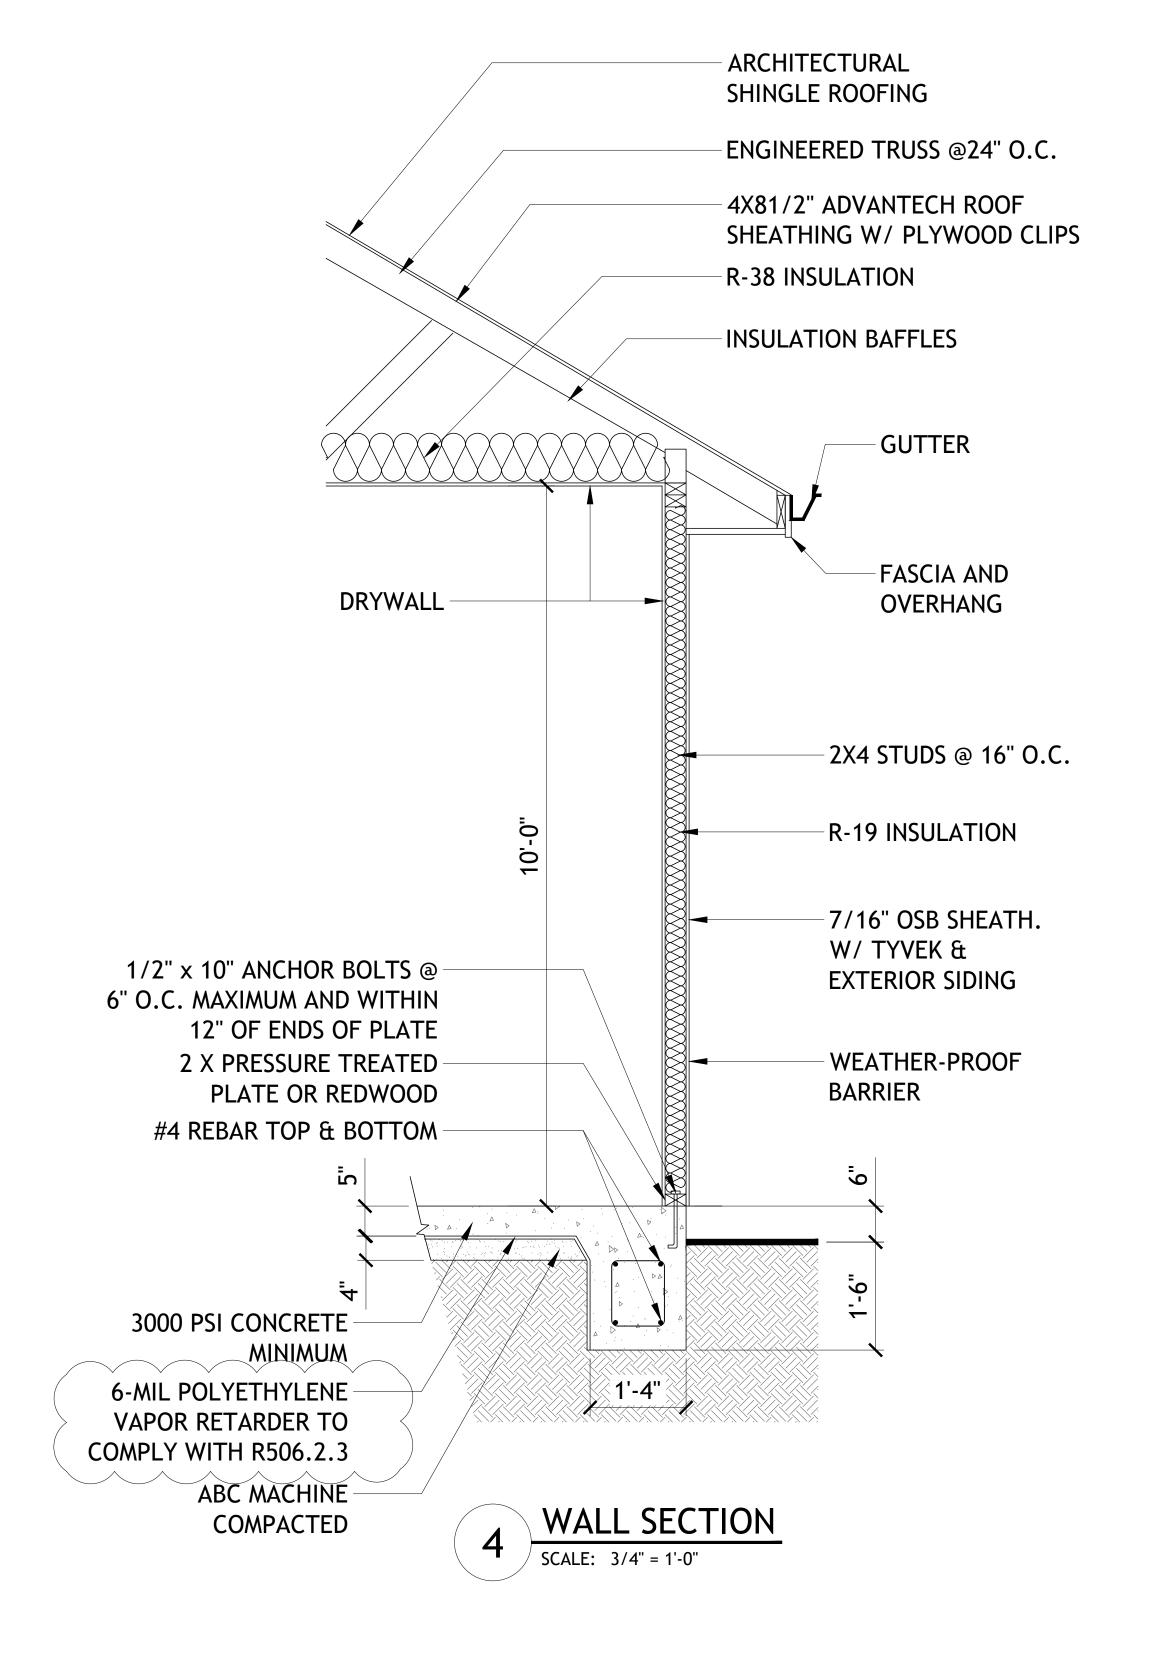



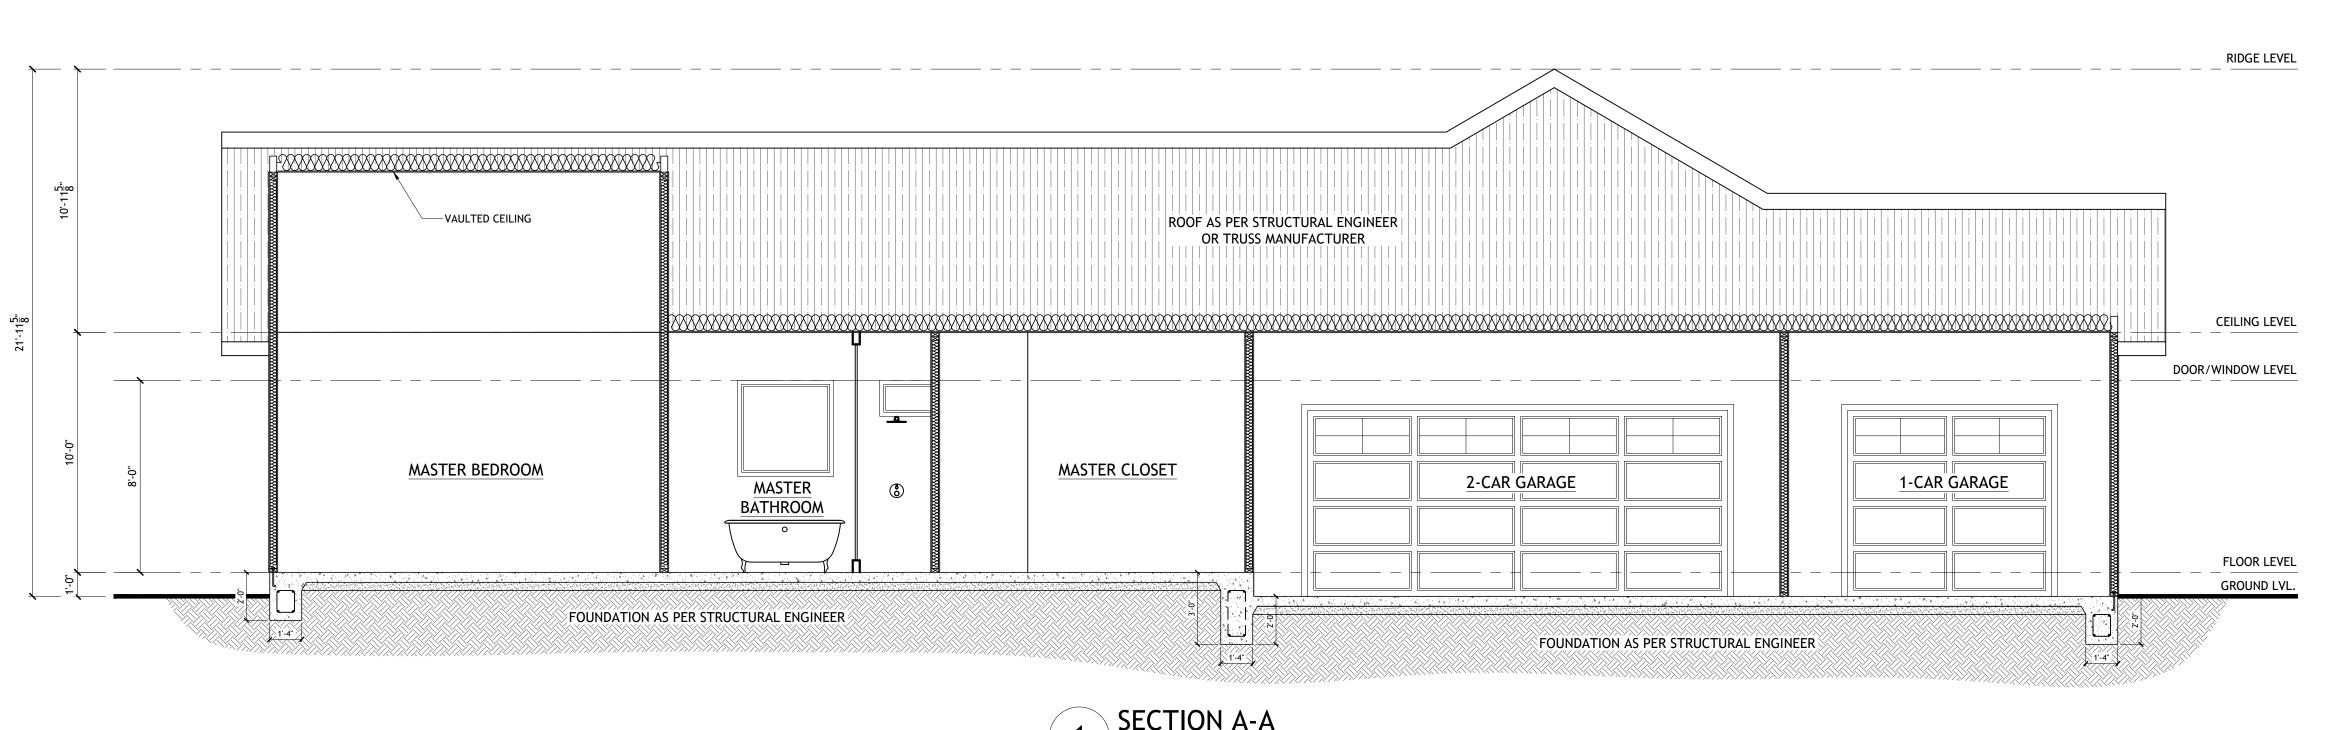

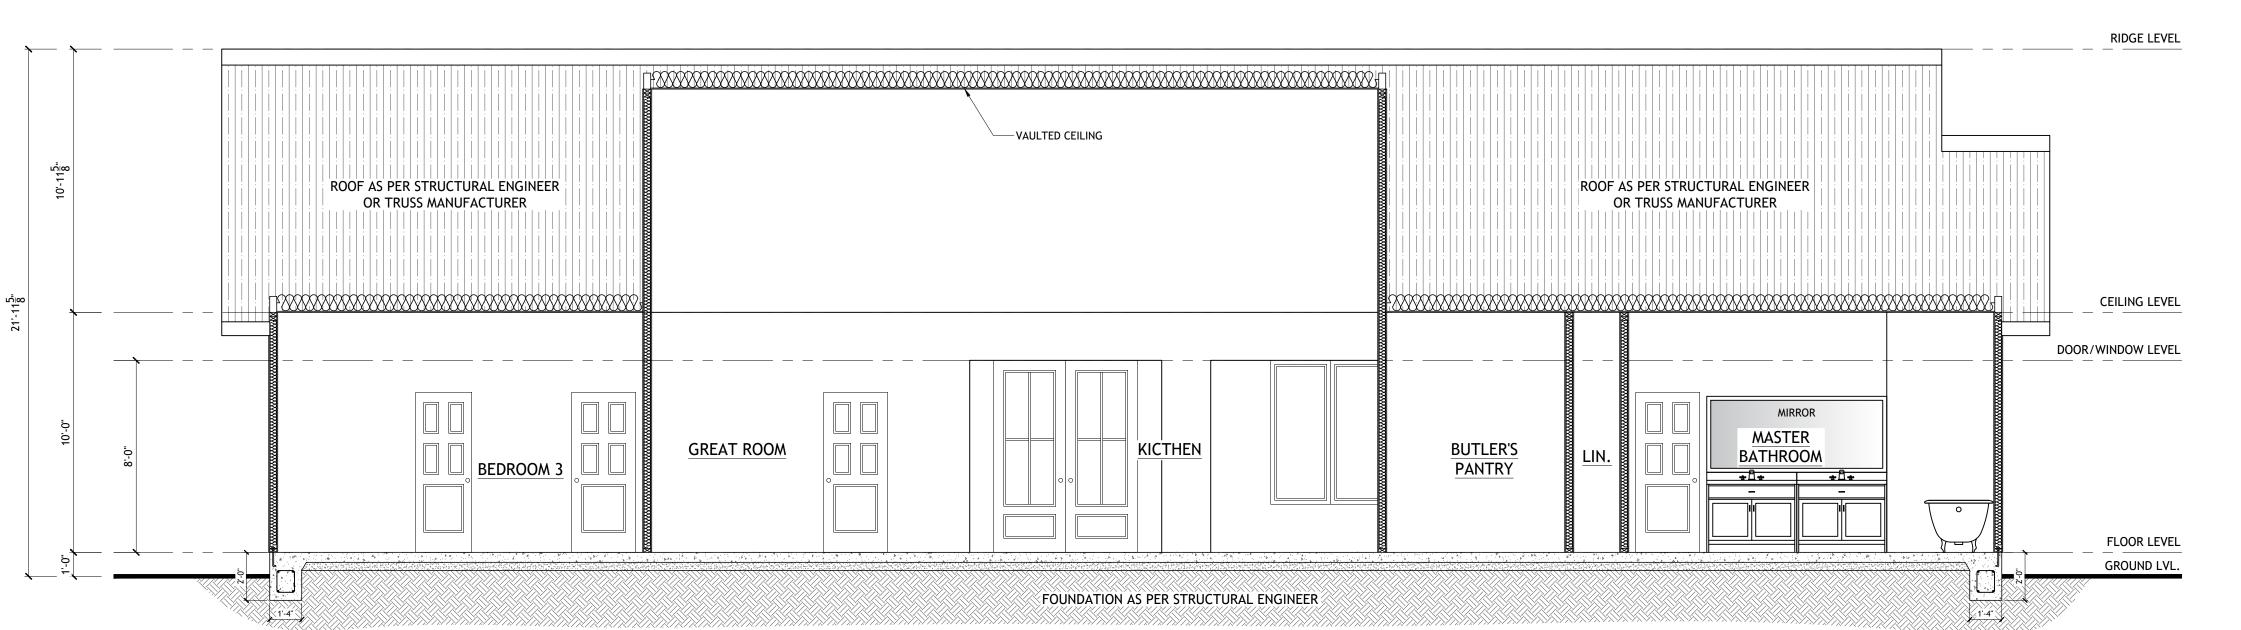



# **GENERAL NOTES:**

- 1. "CODE" WHERE REFERRED TO HEREIN REFERS TO 2018 INTERNATIONAL RESIDENTIAL CODE (IRC). 2. ALL WORK SHALL CONFORM TO THE REQUIREMENTS OF THE CODE.
- 3. ALL MATERIALS AND WORKMANSHIP SHALL CONFORM TO THE DRAWING AND SPECIFICATIONS. 4. THE CONTRACTOR SHALL BE RESPONSIBLE FOR THE SAFETY OF THE BUILDING DURING CONSTRUCTION AND SHALL PROVIDE ADEQUATE SHORING, BRACING AND GUIDE DURING CONSTRUCTION. SAFETY AND BRACING REQUIREMENTS SHALL BE IN ACCORDANCE WITH ALL
- NATIONAL STATE AND LOCAL SAFETY ORDINANCES. 5. THE CONTRACTOR SHALL BE RESPONSIBLE FOR COORDINATING THE WORK OF ALL TRADES AND SHALL CHECK ALL DIMENSIONS.
- 6. SEE MECHANICAL, PLUMBING AND ELECTRICAL DRAWING FOR SIZE AND LOCATION OF ALL OPENINGS REQUIRED FOR DUCTS, PIPES AND FOR ALL PIPE SLEEVES, ELECTRICAL CONDUITS AND OTHER ITEMS TO BE EMBEDDED IN CONCRETE OR OTHERWISE INCORPORATED IN STRUCTURAL WORK
- 7. IN ALL CASES WHERE A CONFLICT MAY OCCUR, SUCH AS BETWEEN ITEMS COVERED IN SPECIFICATIONS AND NOTES ON THE DRAWINGS OR BETWEEN GENERAL NOTES AND SPECIFIC DETAILS, THE ARCHITECT SHALL BE NOTIFIED AND HE WILL INTERPRET THE INTENT OF THE CONTRACT DOCUMENTS
- 8. WHERE CONSTRUCTION MATERIALS ARE TEMPORARILY STORED ON ROOF OR FLOOR FRAMING THEY SHALL BE DISTRIBUTED SO THAT THE LOAD DOES NOT EXCEED THE DESIGN LIVE LOAD.

#### WOOD FRAMING:

1.1 ALL DOUGLAS-FIR LARCH SHALL COMPLY WITH DOC PS20 STANDARDS.

- 1. ALL HORIZONTAL LOAD CARRYING MEMBERS AND POSTS TO BE DOUGLAS FIR LARCH NORTH.
- GRADE NO. 2 TYPICAL U.N.O. B. 4X, 6X GRADE NO. 1 TYPICAL U.N.O.
- C. POST GRADE NO. 1 TYPICAL U.N.O. 2. STUDS, PLATES, SILLS AND BLOCKING TO BE GRADE #2 DOUGLAS FIR OR BETTER. 3. SILLS UNDER STUD PARTITIONS IN CONTACT WITH CONCRETE SHALL PRESSURE TREATED
- DOUGLAS FIR BOLTED TO CONCRETE WITH 5/8" X10" ANCHOR BOLTS SPACED NOT MORE THAN 4'-0" O.C UNLESS NOTED OTHERWISE, THERE SHALL BE ONE BOLT WITHIN 9" OF EACH
- END OF EACH SILL PIECE. MINIMUM OF 2 BOLTS PER PIECE. 4. THE BRIDGING SHALL BE PROVIDED AS PER CODE.
- 5. A.B INTO WOOD FRAMING REQUIRE 3X3X0.229" PLATE WASHERS
- 6. FRAMING MEMBERS SHALL NOT BE NOTCHED IN ANY MANNER EXCEPT WHERE SPECIFICALLY DETAILED OR APPROVED BY THE ARCHITECT.
- 7. MINIMUM NAILING FOR ALL WOOD MEMBERS SHALL BE AS PER CODE UNLESS SPECIFICALLY
- 8. STRUCTURAL PLYWOOD SHALL BE DEPA GRADE, STRUCTURAL CDX, THICKNESS AS NOTED ON PLANS WITH EXTERIOR GLUE CONFORMING TO PRODUCT DOS PS1 OR PS2. EACH SHEET
- SHALL BE IDENTIFIED BY A REGISTERED STAMP OR BRAND. 9. EDGES OF ALL OPENINGS THROUGH ROOF OR FLOOR SHALL BE NAILED PER BOUNDARY OF PLYWOOD DIAPHRAGM NAILING REQUIREMENTS.
- 10. ALL WOOD BEARING ON CONCRETE OR MASONRY SHALL BE PRESSURE TREATED DOUGLAS FIR.
- 11. ALL WOOD FRAMING MAX. MOISTURE CONTENT TO BE 197%. 12. JOIST HANGERS AND OTHER CONNECTORS SHALL BE SIMPSON STRONG TIES OR EQUAL.

#### STRUCTURAL GLUE LAMINATED TIMBER:

- 1. MATERIALS, MANUFACTURE AND QUALITY CONTROL SHALL BE IN CONFORMANCE WITH
- COMMERCIAL STANDARD, CS-253, "STRUCTURAL GLUED LAMINATED TIMBER". 2. GLUED LAMINATED BEAMS SHALL BE COMBINATION 24F-V8, DOUGLAS FIR AND LARCH PER AITC 117=71 OR COMBINATION 24F-V8 WITH HEM FIR LAMINATION PER AITC.
- 3. ALL STRUCTURAL GLUED LAMINATED TIMBER SHALL BE INSPECTED DURING LAMINATION BY AN APPROVED INSPECTION AGENCY. A CERTIFICATE OF INSPECTION SHALL BE PROVIDED FOR THE ARCHITECT & BUILDING DEPARTMENT PRIOR TO ERECTION.
- 4. EACH GLUED LAMINATED BEAM SHALL BE STAMPED WITH IDENTIFICATION NUMBER AND SHALL BE ACCOMPANIED BY A CERTIFICATE OF INSPECTION.
- 5. THE GLUED LAMINATED BEAMS SHALL BE FURNISHED BY A LICENSED FABRICATOR SPECIALIZING IN THIS TYPE OF WORK. THE FABRICATOR SHALL SUBMIT COMPLETE SHOP DRAWINGS TO THE ARCHITECT FOR APPROVAL PRIOR TO FABRICATION.

#### SHEAR WALL SCHEDULE

MARK	CAPACITY	STRUCTURAL I PLYWOOD	NAIL	SPA	ACING		SILL NAIL	SILL BOLTS	REMARKS
	#L.F.	OR OSB	1	BOUND	EDGE	INTERIM			
<b>⟨</b> 7⟩	260	15/32 CDX	8d	4	4	12	16 d @ 3" O.C.	5/8"Ø @ 24" O.C.	
8	380	15/32 CDX	8d	3	3	12	3/8"ØX5"L.G@10" O.C.	5/8"Ø @ 16" O.C.	SEE #2
9>	490	15/32 CDX	8d	2	2	12	3/8"ØX5"L.G@6" O.C.	5/8"Ø @ 12" O.C.	SEE #2
(10)	640	15/32 CDX	10d	2	2	12	3/8"ØX5"L.G@4" O.C.	5/8"Ø @ 8" O.C.	SEE #2

@ T. & B. PLATE EDGE & FIELD (16d SILL NAIL @ 6" O.C.) CBCB YABLE 2306.4.5

1. HOLD-DOWN HARDWARE SECURED IN PLACE PRIOR TO CALLING INSPECTOR.

- SHALL BE TIGHTENED 2. SHEAR PANELS AND DIAPHRAGMS, INCLUDING NAILING, BOLTING, ANCHORING AND OTHER FASTENING TO OTHER COMPONENTS OF THE SEISMIC FORCE—RESISTING
- SYSTEM, WHERE THE FASTENER SPACING OF THE SHEATHING IS € 4" O.C. 3. SILL PL.& STUDS @ EDGE OF PLYWOOD FOR SHEAR WALLS WITH LATERAL LOADS GREATER THAN 300 POUNDS/FOOT REQUIRE A 3 INCH NOMINAL OR GREATER MEMBER.
- 4. ALL BOLT HOLES SHALL BE DRILLED A MAX. OF 1/16" OVERSIZED.

#### 5. 1/2" EDGE DISTANCE FOR PLYWOOD BOUNDARY NAILING. STRUCTURAL STEEL

1. SHALL CONFORM TO THE PROVISIONS OF A.S.T.M. A-572 GR50 UNLESS OTHERWISE NOTED ON PLANS.

- 2. ALL WELDING IS TO COMPLY WITH A.W.S. SPECIFICATIONS AND IS TO BE DONE BY WELDERS APPROVED BY THE DEPARTMENT OF BUILDING AND SAFETY. ALL WELDING WILL BE DONE ELECTRIC ARC PROCESS AND SHALL BE PERFORMED WITH APPROVED ELECTRODES AS REQUIRED PER THE A.L.S.C. SPECIFICATION. WELDS ARE DESIGNED AT FULL STRESS AND MUST BE DONE IN THE SHOP OF A LICENSED FABRICATOR, EXCEPT WHERE OTHERWISE NOTED ON PLANS. CONTINUOUS INSPECTION IS REQUIRED FOR FIELD WELDS.
- 3. ALL BOLTS USED SHALL CONFORM TO A325 UNLESS OTHERWISE NOTED.
- 4. ALL STRUCTURAL STEEL SHALL BE FABRICATED AND ERECTED BY A LICENSED FABRICATOR APPROVED BY THE L.A. CITY OR COUNTY BUILDING DEPARTMENT AND A CERTIFICATE OF FABRICATION OR REPORT FROM THE SPECIAL INSPECTION MUST BE FURNISHED TO THE JOB INSPECTOR PRIOR TO FRAMING APPROVAL
- 5. SHOP DRAWINGS FOR ALL STRUCTURAL AND MISCELLANEOUS STEEL SHALL BE SUBMITTED TO THE THE ARCHITECT AND APPROVAL OBTAINED PRIOR TO FABRICATION.

6. ALL GROUT UNDER STEEL BEARING PLATES SHALL BE SOLID DRYPACK OR NON-SHRINK GROUT

- PLACED AS DIRECTED BY THE MANUFACTURER. 7. CONTINUOUS INSPECTION REQUIRED DURING INSTALLATION OF HIGH-STRENGTH BOLTS FIELD
- WELDING AND ORDINARY FRAMING. 8. ORDINARY MOMENT FRAMING SHALL BE TEST BY NONDESTRUCTIVE METHODS FOR
- COMPLIANCE WITH APPROVED STANDARDS AND JOB SPECIFICATIONS. THIS TESTING SHALL BE A PART OF THE SPECIAL INSPECTION REQUIRED OF SECTION.
- 9. ELECTRIC ARC WELD PROCESS BY OPERATORS APPROVED BY BOARD OF AWS USING E-70XX ELECTRODES IN CONFORMATION TO LOCAL BUILDING CODE. ALL WELDING SHALL BE DONE BY EXPERIENCED AND CERTIFIED WELDERS IN ACCORDANCE W/ THE STANDARDS AND REQUIREMENTS FOR ELECTRIC ARC WELDING OF AWS SPEC. THE CONTRACTOR SHALL PROVIDE
- SUITABLE MEANS FOR CLAMPING OR HOLDING MEMBERS DURING WELDING IN ORDER THAT WARPING OR DISTORTION OF THE STRUCTURAL MEMBERS BE MINIMIZED. LENGTH OF WELDS NOTED ON DETAILS ARE NET AND DO NOT INCLUDE ALLOWANCE FOR CRATERS. ALL WELDS SHALL HAVE 1/4" EXTRA LENGTH EACH END TO ALLOW FOR CRATERS. WELD SHALL BE
- DEPOSITED BY NOT MORE THAN 1/4" THICK PASSES. PARTICULAR CARE SHALL BE EXERCISED TO PREVENT UNDERCUTTING OR REDUCING THE SELECTION OF MATERIALS AT WELDS.
- 10. A CERTIFICATE OF FABRICATION OR REPORT FROM THE SPECIAL INSPECTOR MUST BE FURNISHED TO THE JOB INSPECTOR PRIOR TO FRAMING APPROVAL

# **ANCHORAGE:**

- 1. MIN. TWO BOLTS PER PIECE OF SILL PLATE AND ONE LOCATED WITHIN 12-INCH AND
- NOT LESS THAN 7 BOLT DIAMETER OR 4 INCH OF EACH END OF EACH SILL PLATE. 2. MIN. OF 5/8" DIAMETER A.B. EMBEDDED 7 INCH INTO FOOTING AND SPACED NOT
- MORE THAN 6' ON CENTER FOR ONE—STORY BUILDINGS OR 4 FEET ON CENTER TWO—STORY BUILDINGS 3. 3"X3"X0.229" PLATE WASHER SHALL BE USED ON EACH A.B.

4. ALL ANCHOR BOLTS AND HOLDOWNS SHALL BE TIED IN PLACE PRIOR TO FOUNDATION INSPECTION.

#### FRAMING NOTES:

- 1. ROOF SHEATHING TO BE 1/2" CDX PLYWOOD OR OSB (INDEX 24/0) WITH
- 8D COMMON NAIL AT: 6" O.C. IN BOUNDARY,
- 12" 0O.C. IN INTERMEDIATED (FIELD),
- 2. FLOOR SHEATHING TO BE 5/8" CD T & G PLYWOOD OR OSB (INDEX 32/16) WITH 10D COMMON NAIL AT: 6" O.C. IN BOUNDARY,
- 10" 0.C.IN INTERMEDIATED (FIELD),
- 3. WOOD DIAPHRAGM TO BE INSPECTED AND APPROVED BY BUILDING
- DEPARTMENT PRIOR TO COVERING. 4. SEE DETAIL 5/S-1 FOR TYPICAL WALL SHEATHING DETAIL.
- 5. SEE DETAIL 4/S-1 FOR TYPICAL DIAPHRAGM DETAIL AND NOTES
- 6. SEE DETAIL ON FRAMING PLAN FOR SHEAR WALL INDICATED BY 7. SEE SHEAR WALL DENOTE FULL LENGTH AND FULL HEIGHT OF THE WALLS.
- 8. STRUCTURAL OBSERVATION WILL BE PERFORMED WHEN REQUIRED BY THE BUILDING OFFICIAL. 9. A CERTIFICATE OF COMPLIANCE WILL BE PROVIDED FOR THE LAMINATED BEAMS.
- 10. THE MAX. DEPTH OF NOTCHING SHALL NOT EXCEED 1/6 THE DEPTH OF THE MEMBER
- AND SHALL NOT BE LOCATED IN THE MIDDLE 1/3 OF THE SPAN. 11. THE MAX. DEPTH OF NOTCHING SHALL NOT EXCEED 1/4 THE DEPTH AT END OF SPANS.
- 12. PROVIDE SOLID 2X BLOCKING UNDER PARTITIONS PERPENDICULAR TO FLOOR JOIST
- 13. PROVIDE DOUBLE JOIST UNDER PARALLEL BEARING PARTITIONS 14. ROOF SHEATHING REQUIRES NAILING INSPECTION BEFORE COVERED.
- 15. HOLDOWN SHALL BE TIGHT BEFORE COVERED PLYWOOD SHEATHING. 16. 2-LAYER #15 BLACK PAPER COVERED PLYWOOD SHEATHING FOR SHEAR WALL.
- 17. STUCCO LATH& DRYWALL SHALL BE NAILED TO ALL STUDS & TO TOP & BOTTOM PL. 18. ROOF PLYWD SHALL BE BOND W/ INT. & EXT. GLUE & BE OF EXT. TYPE WHERE EXPOSED TO WEATHER.

#### **FOUNDATION NOTES:**

- 1. FOR FLOOR DIMENSION, CURBS, UNDER FLOOR DUCTS, CONDUITS, ETC.
- 2. VERIFY ALL CONDITIONS IN FIELD.
- 3. SEE DETAIL ON PLAN/S—1 FOR SHEAR WALL INDICATED BY 4. SEE DETAIL 1/S-1 FOR TYPICAL SLAB ON GRADE, CONTROL JOINTS, AND SLAB
- DEPRESSION DETAILS.
- 5. SHEAR WALLS > DENOTE FULL LENGTH AND FULL HEIGHT OF THE WALL
- 6. ANCHOR BOLTS ARE 5/8"¢ @48"0.C WITH GALVANIZED PLATE WASHER 3"X3"X0.229". ANCHOR BOLTS SHALL BE 12" AT EACH END WITH 7" MIN. EMBEDMENT.
- 7. ALL HOLDOWN HARDWARE, ANCHOR BOLTS & REBARS TO BE SECURED IN PLACE PRIOR TO CALL FOR INSPECTION. 8. SATURATE THE SOIL 18" DEEP BEFORE PLACING THE CONCRETE SLAB.
- 9. GRADING & FOOTING TO BE INSPECTED & CERTIFIED BY THE SOIL ENGINEER PRIOR TO POURING THE CONCRETE 10. FASTENERS IN PRESERVATIVE TREATED WOOD OR FIRE RETARDANT TREATED WOOD SHALL BE OF

HOT DIPPED ZINC COATED GALVANIZED STEEL OR STAINLESS STEEL. IN ACCORDANCE W/ASTM A153.

#### **CONCRETE:**

- 1. CEMENT: TYPE V CONFORMING TO A.S.T.M. C--150 C.B.C.
- 2. ALL CONCRETE UNLESS OTHERWISE NOTED ON PLANS WILL BE REGULAR WEIGHT HARD ROCK TYPE (150 1B/CU.FT.). AGGREGATE SHALL CONFORM TO A.S.T.M. C-33 WITH PROVEN SHRINKAGE CHARACTERISTICS OF LESS THAN 0.04% AS PER A.S.T.M. C-157.
- 3. STRENGTHS: ULTIMATE COMPRESSIVE STRENGTH AT 28 DAYS F'C=2500 PSI, ACI 318-11 4. MAXIMUM SLUMP OF CONCRETE USED IN FLOOR SLAB AT FLAT WORK SHALL BE FOUR(4)
- 5. VIBRATION: VIBRATION OF CONCRETE SHALL BE IN ACCORDANCE WITH THE GENERAL
- PROVISIONS OUTLINED IN PORTLAND CEMENT ASSOCIATION SPEC. ST26. 6. CURING: CONCRETE SHALL BE MAINTAINED IN A MOIST CONDITION FOR A MINIMUM OF FIVE DAYS AFTER ITS PLACEMENT. APPROVED CURING COMPOUNDS MAY BE USED IN LIEU OF MOIST CURING.
- 7. STRENGTH TESTS OF CONCRETE SHALL BE REQUIRED AS PER CODE AND AS OUTLINED IN SPECIFICATION REPORTS TO BE FORWARD TO THE STRUCTURAL ENGINEER. 8. ANCHOR BOLTS, DOWELS, INSERTS, ETC. SHALL BE SECURELY TIED IN PLACE PRIOR TO
- FOUNDATION INSPECTION 9. LOCATION OF CONSTRUCTION AND POUR JOINTS SHALL BE APPROVED BY THE ARCHITECT
- POURING CONCRETE. 10. CONTINUOUS INSPECTION REQUIRED FOR CONCRETE F'C GREATER THAN 2500 PSI.

#### **SOIL INFO.:**

1. THE FOUNDATION DESIGNED IS BASED ON THE RECOMMENDATIONS BY CBC 2016 TABLE 2. THE SOIL BEARING VALUE USED FOR DESIGN OF FOOTING UPON UNDISTURBED SOILS AND

24" BELOW LOWEST FINISHED GRADE IS: 1500 PSF FOR SPREAD FOOTINGS, 1500 PSF


FOR CONTINUOUS FOOTINGS. 3. SOIL ENGINEER MUST INSPECT AND APPROVE FOOTING EXCAVATION PRIOR TO PLACING REBARS AND APPROVAL TO BE PROVIDED TO THE BUILDING INSPECTOR BEFORE CITY APPROVAL OF FOUNDATION.

## **REINFORCING STEEL:**

- 1. A. ALL REINFORCED STEEL TO CONFORM TO A.S.T.M. SPECIFICATION A615 GRADE 60 UNLESS NOTED OTHERWISE ON PLANS.
- B. DEFORMATIONS SHALL BE IN ACCORDANCE WITH A.S.T.M. A615.
- 2. UNLESS OTHERWISE NOTED, ALL REINFORCING STEEL SHALL BE LAPPED 36 BAR DIAMETER OR 2'=0" MINIMUM WHICHEVER GOVERNS. ALL SPLICES SHALL BE LOCATED AS
- DETAILED ON PLANS. 3. CERTIFICATION AND TESTING OF REINFORCING STEEL SHALL BE IN ACCORDANCE WITH THE
- PROVISION OF A.S.T.M. STANDARDS. 4. ALL REINFORCING STEEL SHALL BE SUPPORTED AND TIED IN CONFORMANCE WITH THE LATEST EDITION OF "THE MANUAL OF REINFORCING STEEL PRACTICE FOR REINFORCED CONCRETE STRUCTURES".
- 5. PROVIDE THE FOLLOWING MINIMUM PROTECTIVE COVERING OF CONCRETE UNLESS OTHERWISE NOTED: DEPOSITED AGAINST EARTH IN CONTACT WITH EARTH (FORMED) 2" CLEAR

#### UNIFORM CODE PROGRAM SPECIAL INSPECTION PROGRAM

THIS FORM TO	SPECIAL INSPECTION PROGRAM  D BE ATTACHED TO THE CONSTRUCTION PLANS PRIOR TO PERMIT APPROVAL	
ITEMS ONLY CHECKED ITEMS ARE REQUIRED)	INDIVIDUAL/FIRMS*TO PERFORM S.I.	
CONCRETE	☐ ALL CONCRETE ☐ ALL EXCEPT	
	☐ TEST:PERC.Y.:@ 7 DAYS,@ 28 DAYS,HOLD.	
BOLTS INSTALLED IN CONCRETE	U BOLTS IN EXISTING CONCRETE/MASONRY O BOLTS IN SHEAR WALLS	
SECIAL MOMENT-RESISTING CONCRETE FRAME	☐ LOCATION AS INDICATED IN ALL CONCRETE FRAMES ☐ ☐ TEST:PERC.Y.:@ 7 DAYS,@ 28 DAYS,HOLD.	
REINFORCING STEEL AND PRE-STRESSING TENDONS	☐ STRESSING AND GROUTING OF TENDONS  STEEL PLACEMENT ☐ PERIODIC INSPECTION ☐ CONTINUOUS INSPECTION	
STRUCTURAL WELDING	□ ALL WELDING EXCEPT  PERIODIC: □ SINGLE PASS FILLET WELDS < \( \frac{5}{16} \) CLADDING COINNECTION  □ WELDED STUDS COLD FORMED STUDS METAL DECK □ STAIRS & RAILING REINFORCING STEEL  NDT: □ UT □ Rg □ MPT □ PT	
HIGH STRENGTH BOLTING	SNUG TIGHT:  ALL  AS INDICATED  PRETENSION:  ALL  AS INDICATED	
STRUCTURAL MASONRY	WORKING STRESS DESIGN     ☐ FULL     ☐ HALF STRESSES     ☐ AS INDICATED       ☐ STRENGTH DESIGN     fm =psi       TESTING:     BEFORE     DURING     OTHER REMARKS       PRISM     ☐       GROUT     ☐       MORTAR     ☐       UNITS     ☐	
PILING DRILLED PIERS AND CAISSONS	☐ INSPECTION BY GEOTECHNICAL ENGINEER IN ADDITION TO S.I. ☐ LOAD TESTING ☐ DRIVING ☐ CONTINUOUS INSPECTION ☐ PERIODIC INSPECTION ☐ DRIVING ☐ CONTINUOUS INSPECTION ☐ PERIODIC INSPECTION	
SHOTCRETE	☐ PRE-CONSTRUCTION PANEL TESTING ☐ IN-PLACE CORE TESTING	
OTHERS	☐ EPOXY HOLDOWN AND ANCHORAGE SYSTEM (PERIODIC)	
	SW AND SSW WALL (PERIODIC)	

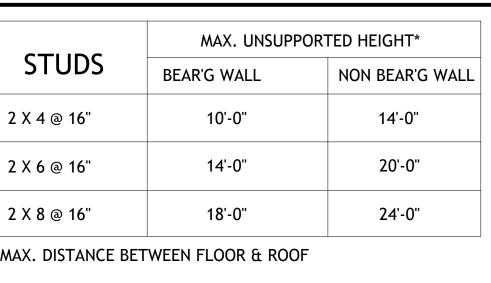

# \*MAX. DISTANCE BETWEEN FLOOR & ROOF - 2X STUDS @16" O.C. U.N.O.

WOOD STUD SCHEDULE

CLG. JOIST

16" O.C.

CEILING JOIST ARE DESIGNED FOR DRYWALL OR PLAST (D.L. = 5 P.S.F. N.L.L. = 10 P.S.F.)

2X BLK'G

CEILING JOIST SCHEDULE

JOSIT SPAN (MAX.)

12'-0"

10'-0"

18'-0"

16'-0"

24'-0"

21'-0"

26'-0"

24'-0"

NAILING SCHEDULE (IRC 2018 TABLE 2304.9.1)

(ALL NAILS SHALL BE UTILIZE COMMON NAILS)

**CEILING JOIST SCHEDULE** 

QUALITY CONTROL PROGRAM

AND DESIGNATION OF

STRUCTURAL OBSERVER

STRUCTURAL OBSERVATION

(ONLY CHECKED ITEMS ARE REQUIRED)

WALL

CONCRETE

MASONRY

WOOD

OTHERS:

STRONG WALL

OR INDIVIDUAL IS HIRED BY ME, AND NOT BY OTHERS, TO BE THE STRUCTRUAL OBSERVER.

DECLARATION BY ENGINEER OR ARCHITECT OF RECORD(REQUIRED IF DIFFERENT FROM THE LIS

. THE OWNER OF THE PROJECT, DECLARE UNDER PENALTY OF PERJURY THAT THE ABOVE LISTED FIRM

, THE ENGINEER OR ARCHITECT OF RECORD FOR THE PROJECT, DECLARE UNDER PENALTY OF PERJURY

THAT THE ABOVE LISTED FIRM OR INDIVIDUAL IS DESIGNATED BY ME TO BE RESPONSIBLE FOR THE

**ARCHITECT** 

FIRM OR INDIVIDUAL TO BE RESPONSIBLE FOR THE STRUCTURAL OBSERVATION:

PHONE:

W/2-16d @

EA. STUD

SIZE

SPACING

12" O.C.

16" O.C.

12" O.C.

16" O.C.

12" O.C.

16" O.C.

12" O.C.

16" O.C.

. JOIST TO SILL OR GIRDER TOE NAIL

7. TOP PL. TO STUD END NAIL.

10. DOUBLE TOP PLS. FACE NAIL

12. CONTINUOUS HDR. TWO PIECES.

14. CONTINUOUS HDR. TO STUD TOE NAIL

18. 1" BRACE TO EA. STUD S PL. FACE NAIL.

. WIND IMPORTANCE FACTOR I=1.0, RISK CATEGORY II

. MAPPED SPECTRAL RESPONSE ACCELERATIONS

13. CLG. JOISTS TO PL. TOE NAIL.

9. DOUBLE STUDS FACE NAIL

17. RAFTER TO PL. TOE NAIL

21. BUILT-UP CNR. STUDS.

VIND & EARTHQUAKE DESIGN DATA:

I. ROOF DL=14 PSF, ROOF LL=20 PSF,

7.SPECTRAL RESPONSE COEFFIENTS

9. BASIC SEISMIC—FORCE—RESISTING

SYSTEM: WOOD SHEAR WALL SYSTEM

1. SEISMIC RESPONSE COEFFIENT: Cs=0.261 2. RESPONSE MODIFICATION FACTOR: R=4

13. ANALYSIS PROCEDURE USED: SEE LATERAL DESIGN

O. DESIGN BASE SHEAR: V=Cs\*Wt

4. REDANDUNCY FACTOR Rho=1.3

8. SEISMIC DESIGN CATEGORY D

4. FLOOR DL=14 PSF, FLOOR LL=40 PSF

BAISIC WIND SPEED=110 MPH

. WIND EXPOSURE=C

Sds=1.693, Sd1=0.848

PROJECT ADDRESS:

OWNER:

NAME:

OTHERS:

SIGNATURE DATE \_

SIGNATURE

STRUCTURAL OBSERVER)

STRUCTURAL OBSERVATION.

FOUNDATION

MAT FOUNDATION

FOOTING, STEM, WALLS, PIERS

CAISSON, PILES, GRADE, BEAMS

HILLSIDE SPECIAL ANCHORS

STEPP'G/RETAIN;G FOUNDATION

DELARATION BY OWNER(REQUIRED IN ANY CASE)

DESCRIPTION OF WORK:

6. SITE CLASS D

2. BRIDGING TO JOIST TOE NAIL EA. END.

6. SOLE PL. TO JOIST OR BLKING FACE NAIL.

3. 1X6 SUB FIR OR LESS TO EA. JOIST FACE NAIL

11. TOP PLS. LAPS & INTERSECTIONS FACE NAIL.

15. CLG. JOISTS LAPS OVER PARTITIONS FACE NAIL.

16. CLG. JOISTS TO PARALLEL RAFTERS FACE NAIL.


19. 1X8 SHT'G OR LESS TO EA. BEARING FACE NAIL.

20. WIDER THAN 1X8 SHT'G TO EA. BEARING FACE NAIL.

4. WIDER THAN 1X6 SUB FLR. TO EA. JOIST FACE NAIL

8. STUD TO SOLE PL. 4—8d TOE NAIL OR 2-20d END NAIL.

5. 2" SUB FLOOR TO JOIST OR GIRDER BLIND & FACE NAIL.

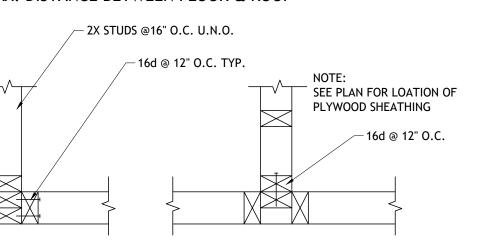

3

6

NAILING

16d @ 16"O.C.

16d @ 24"O.C

16d @ 16"O.C

16d @ 16"O.C.

16d @ 24"O.C

─ 2-2X JOISTS

+ 16d NAI

@8" O.C

DIAPHRAGM

□ CONCRETE

WOOD

OTHERS:

STEEL DECK

2- 8d

2- 8d

3- 16d

2- 16d

4- 8d

3- 16d

3- 8d

2- 8d

3- 8d

-1/2" DIM. M.B. @ 32"

O.C. STAGG TYP.

PERMIT APPL. NO:

**ENGINEER:** 

**REGISTRATION:** 

FRAME

OTHERS:

STEEL MOMENT FRAME

STEEL MOMENT FRAME

MASONRY WALL FRAME

CONCRETE MOMENT FRAME

3- 16d

- 2XDBL PLS.

REMARKS

THIS SCHEDULE APPLIES TO ALL RMS.

FOR CLG. HEIGHT FIN. & SPECIFIC

REQMTS.

U.N.O. ON PLANS SEE ARCH'L DRAWINGS

PLYWD. AS NOTED

STUD @ 16" O.C. U.N.O. -

2-2X EXCEPT AS NOTED

ON FOUND. PLAN

STAGGERED PLYWD.

EDGE NAIL'G -

**BOUNDARY** -

NAILING

SPLICES


2X BLOCKING -


TOP OF CONC. -

SEE SHEAR WALL

SCHED FOR A.B.


WHERE PLYWD. OCCUR @ EA. SIDE STAGG. PANEL JOINT

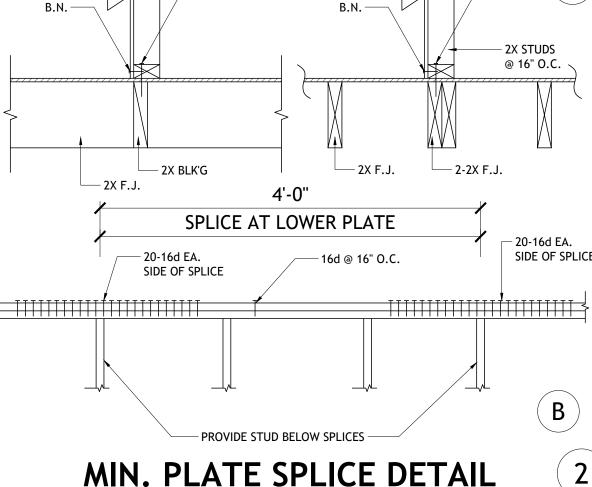

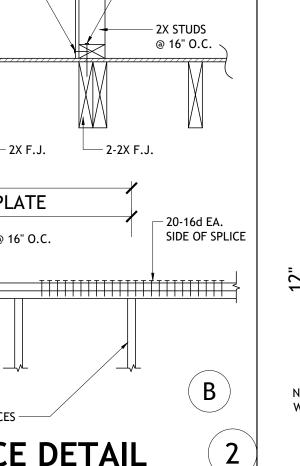

- NAIL @ 12" O.C.

INTERIM NAILING

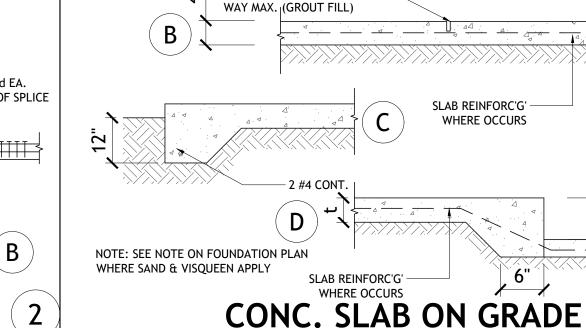



#3X 3'-0" @ 24" O.C.


1/4" DEPTH SAWCUT OR -

QUICK JOIST @ 20'-0" EA.


SMOOTH DOWELS

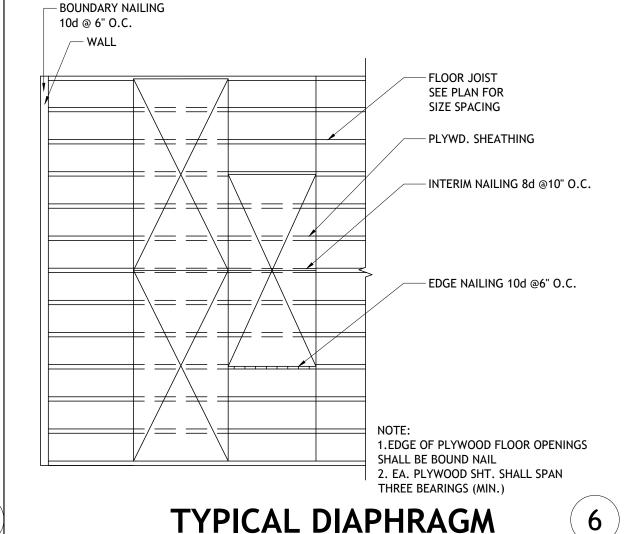


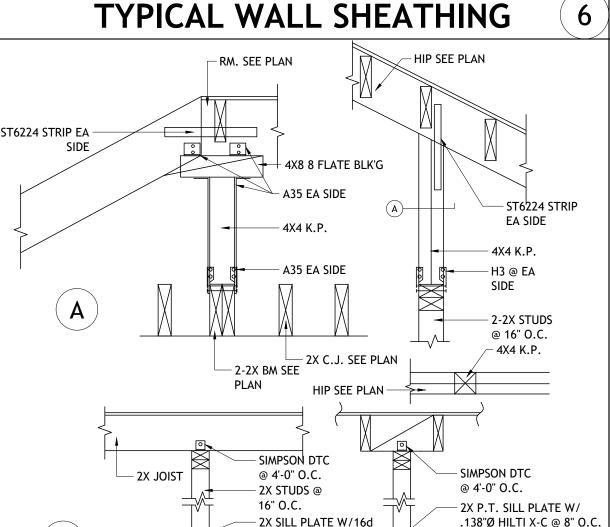

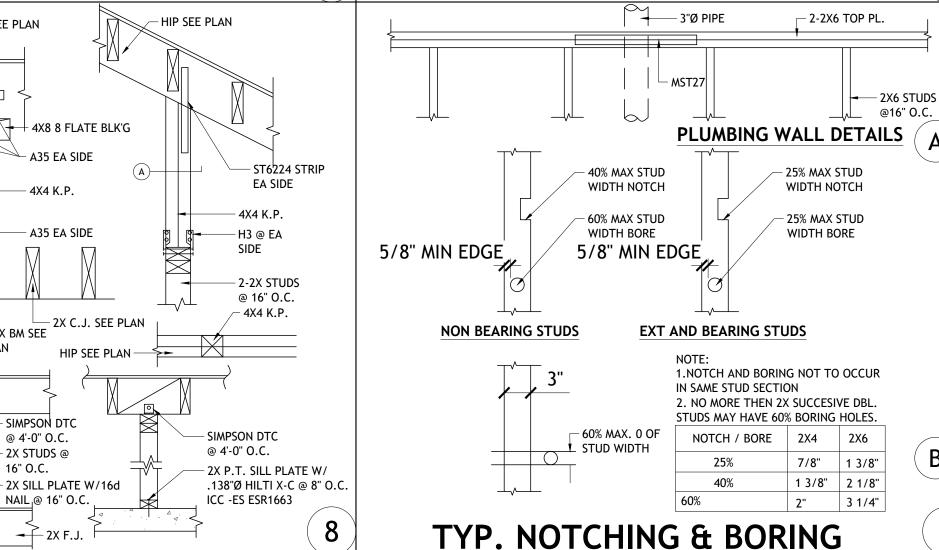


2- 2X8

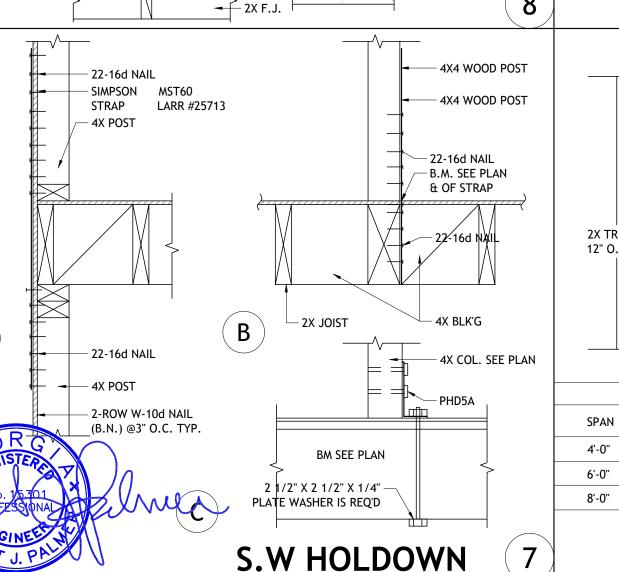

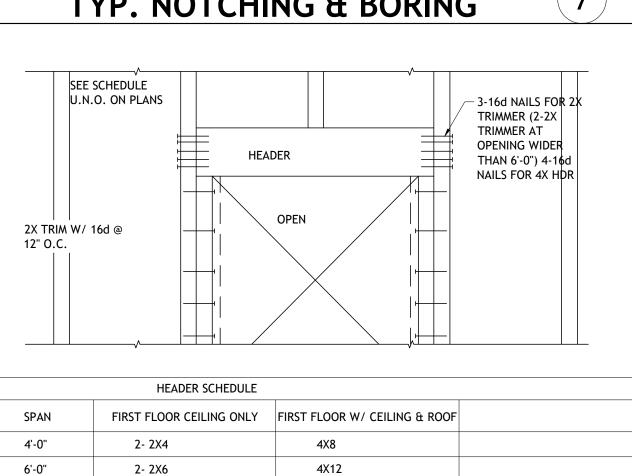



2X 4 KEY CONT.

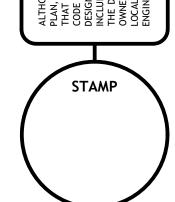

2- 2XTRIM

RELEASED FOR CONSTRUCTION

